


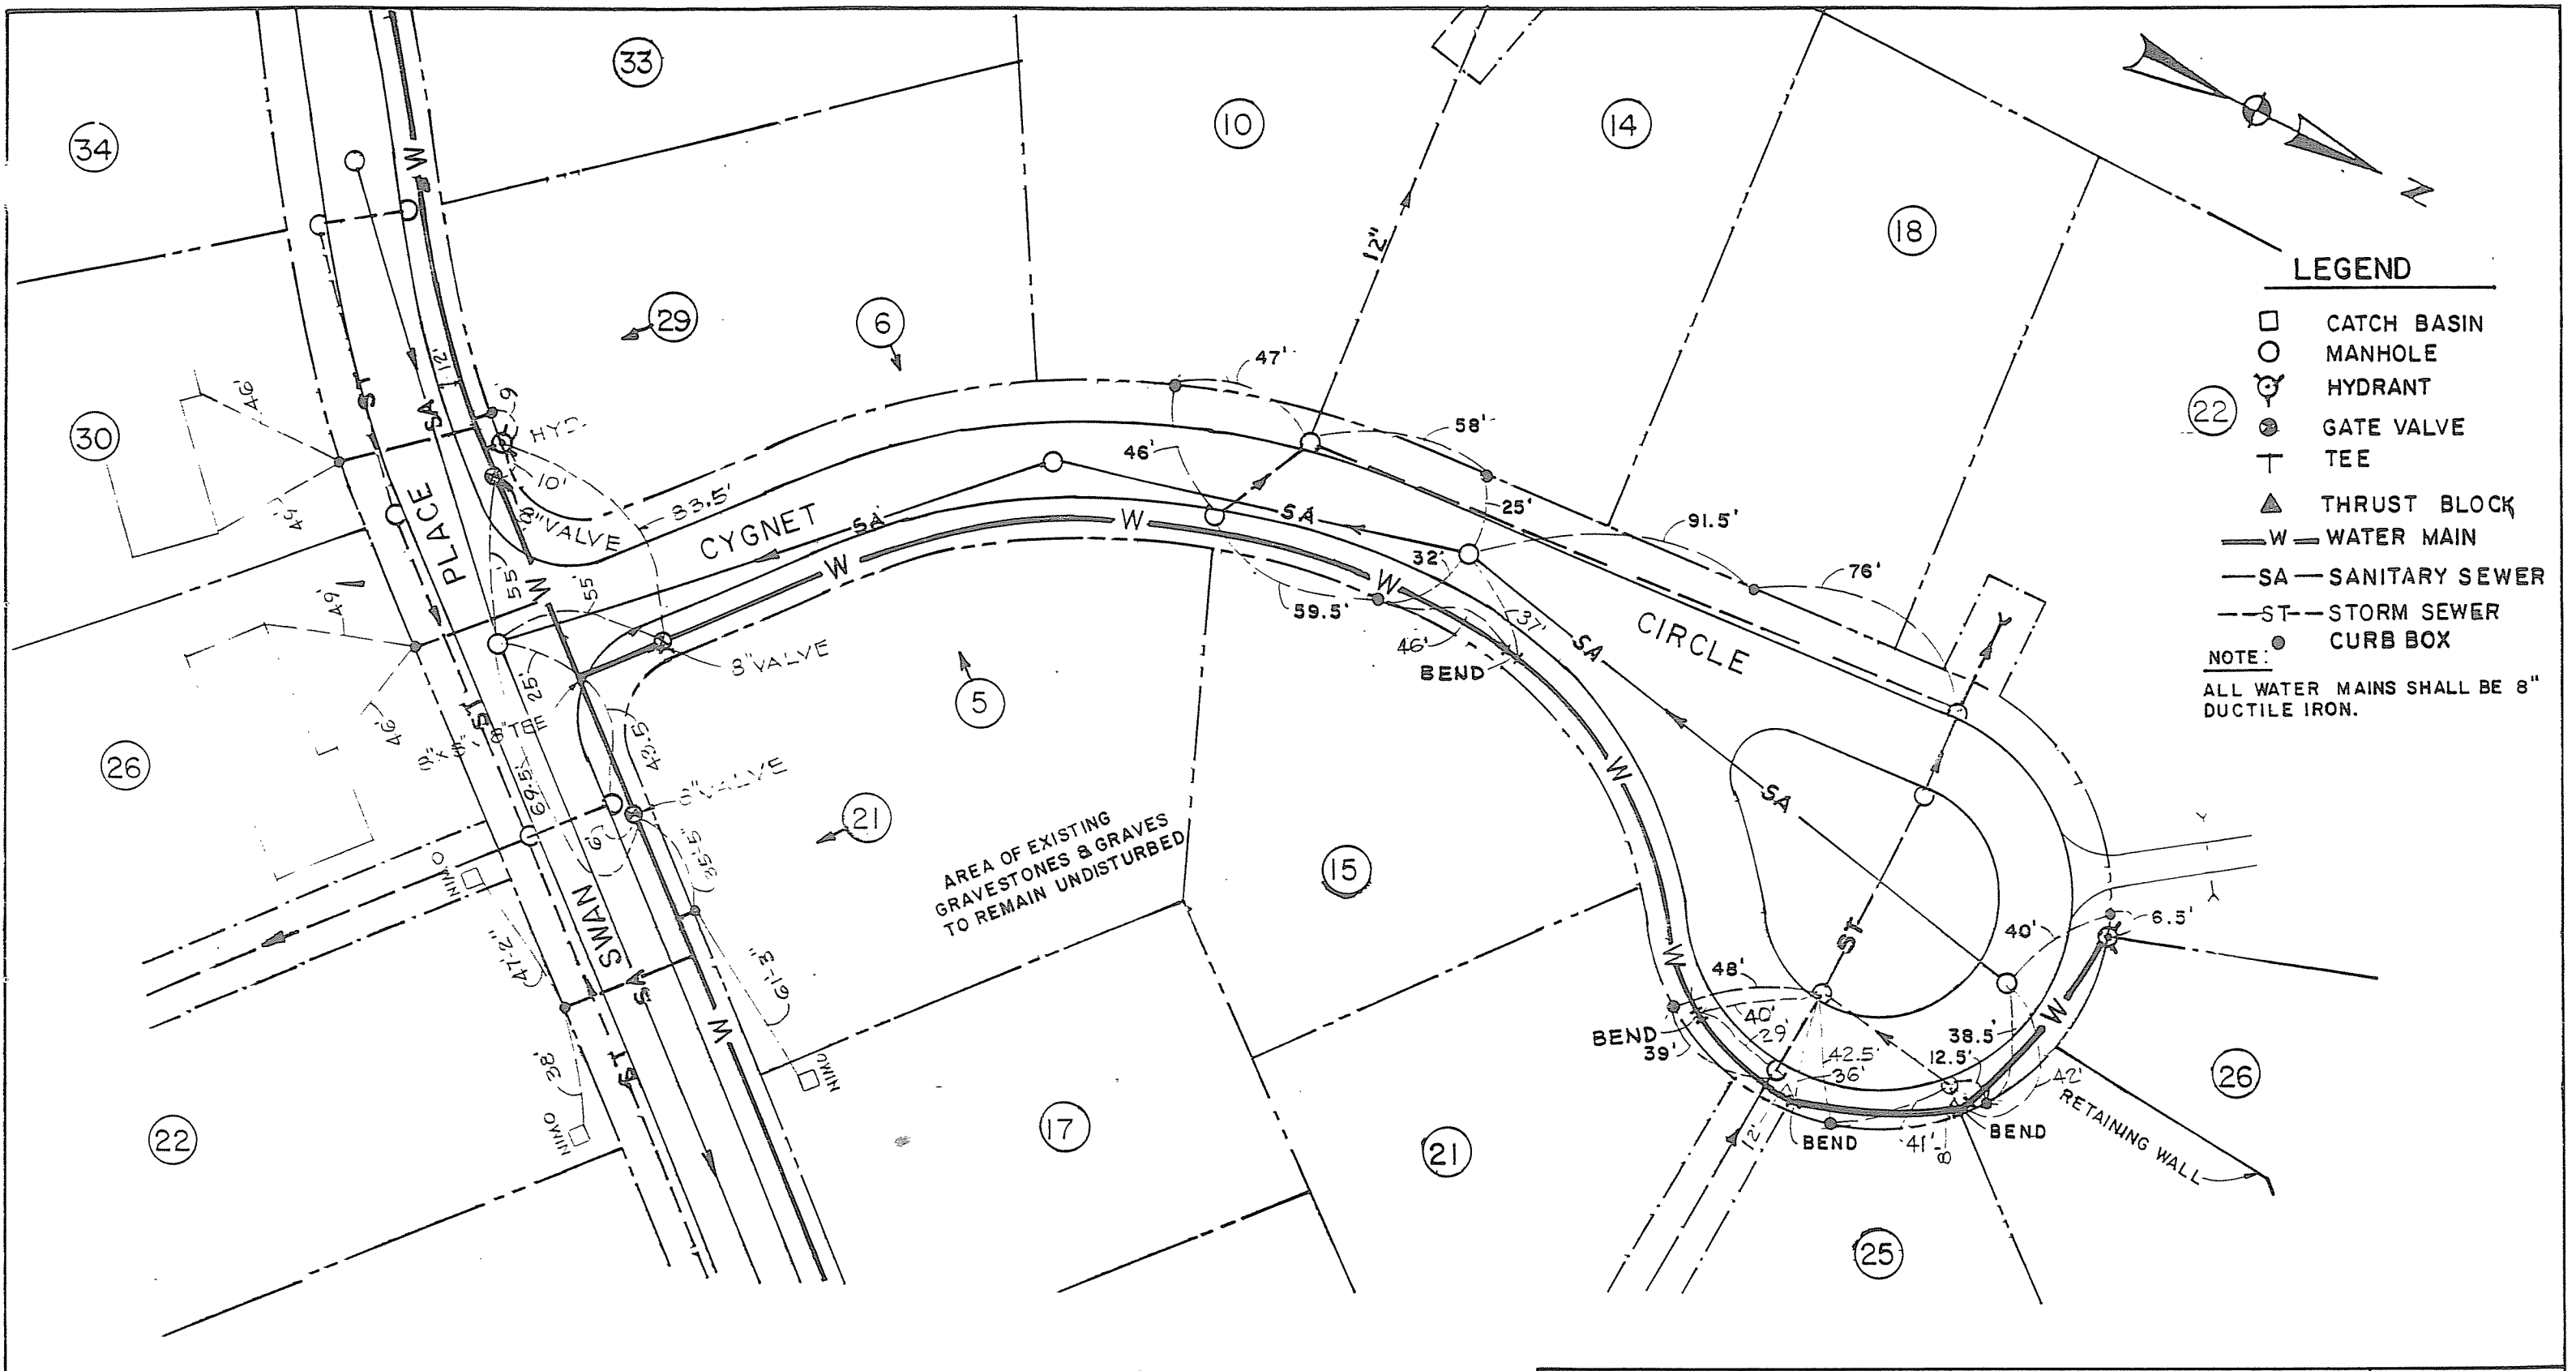

LEGEND

- CATCH BASIN
- MANHOLE
- ⊙ HYDRANT
- ⊙ GATE VALVE
- ⊥ TEE
- ▲ THRUST BLOCK
- W— WATER MAIN
- SA— SANITARY SEWER
- ST--- STORM SEWER
- CURB BOX

NOTE:
ALL WATER MAINS SHALL BE 8" DUCTILE IRON.

COUNTY ALBANY	CYGNET CIRCLE WATER MAIN FISHER HOLLOW CONTRACTOR: SCHULTZ	STATE NEW YORK
DATE JUNE 26, 1998		SCALE 1" = 50'
REVISION		DRAWING NO.



TOWN OF BETHLEHEM
ENGINEERING DIVISION
445 Delaware Ave. Delmar, New York 12054

FISHER HOLLOW