


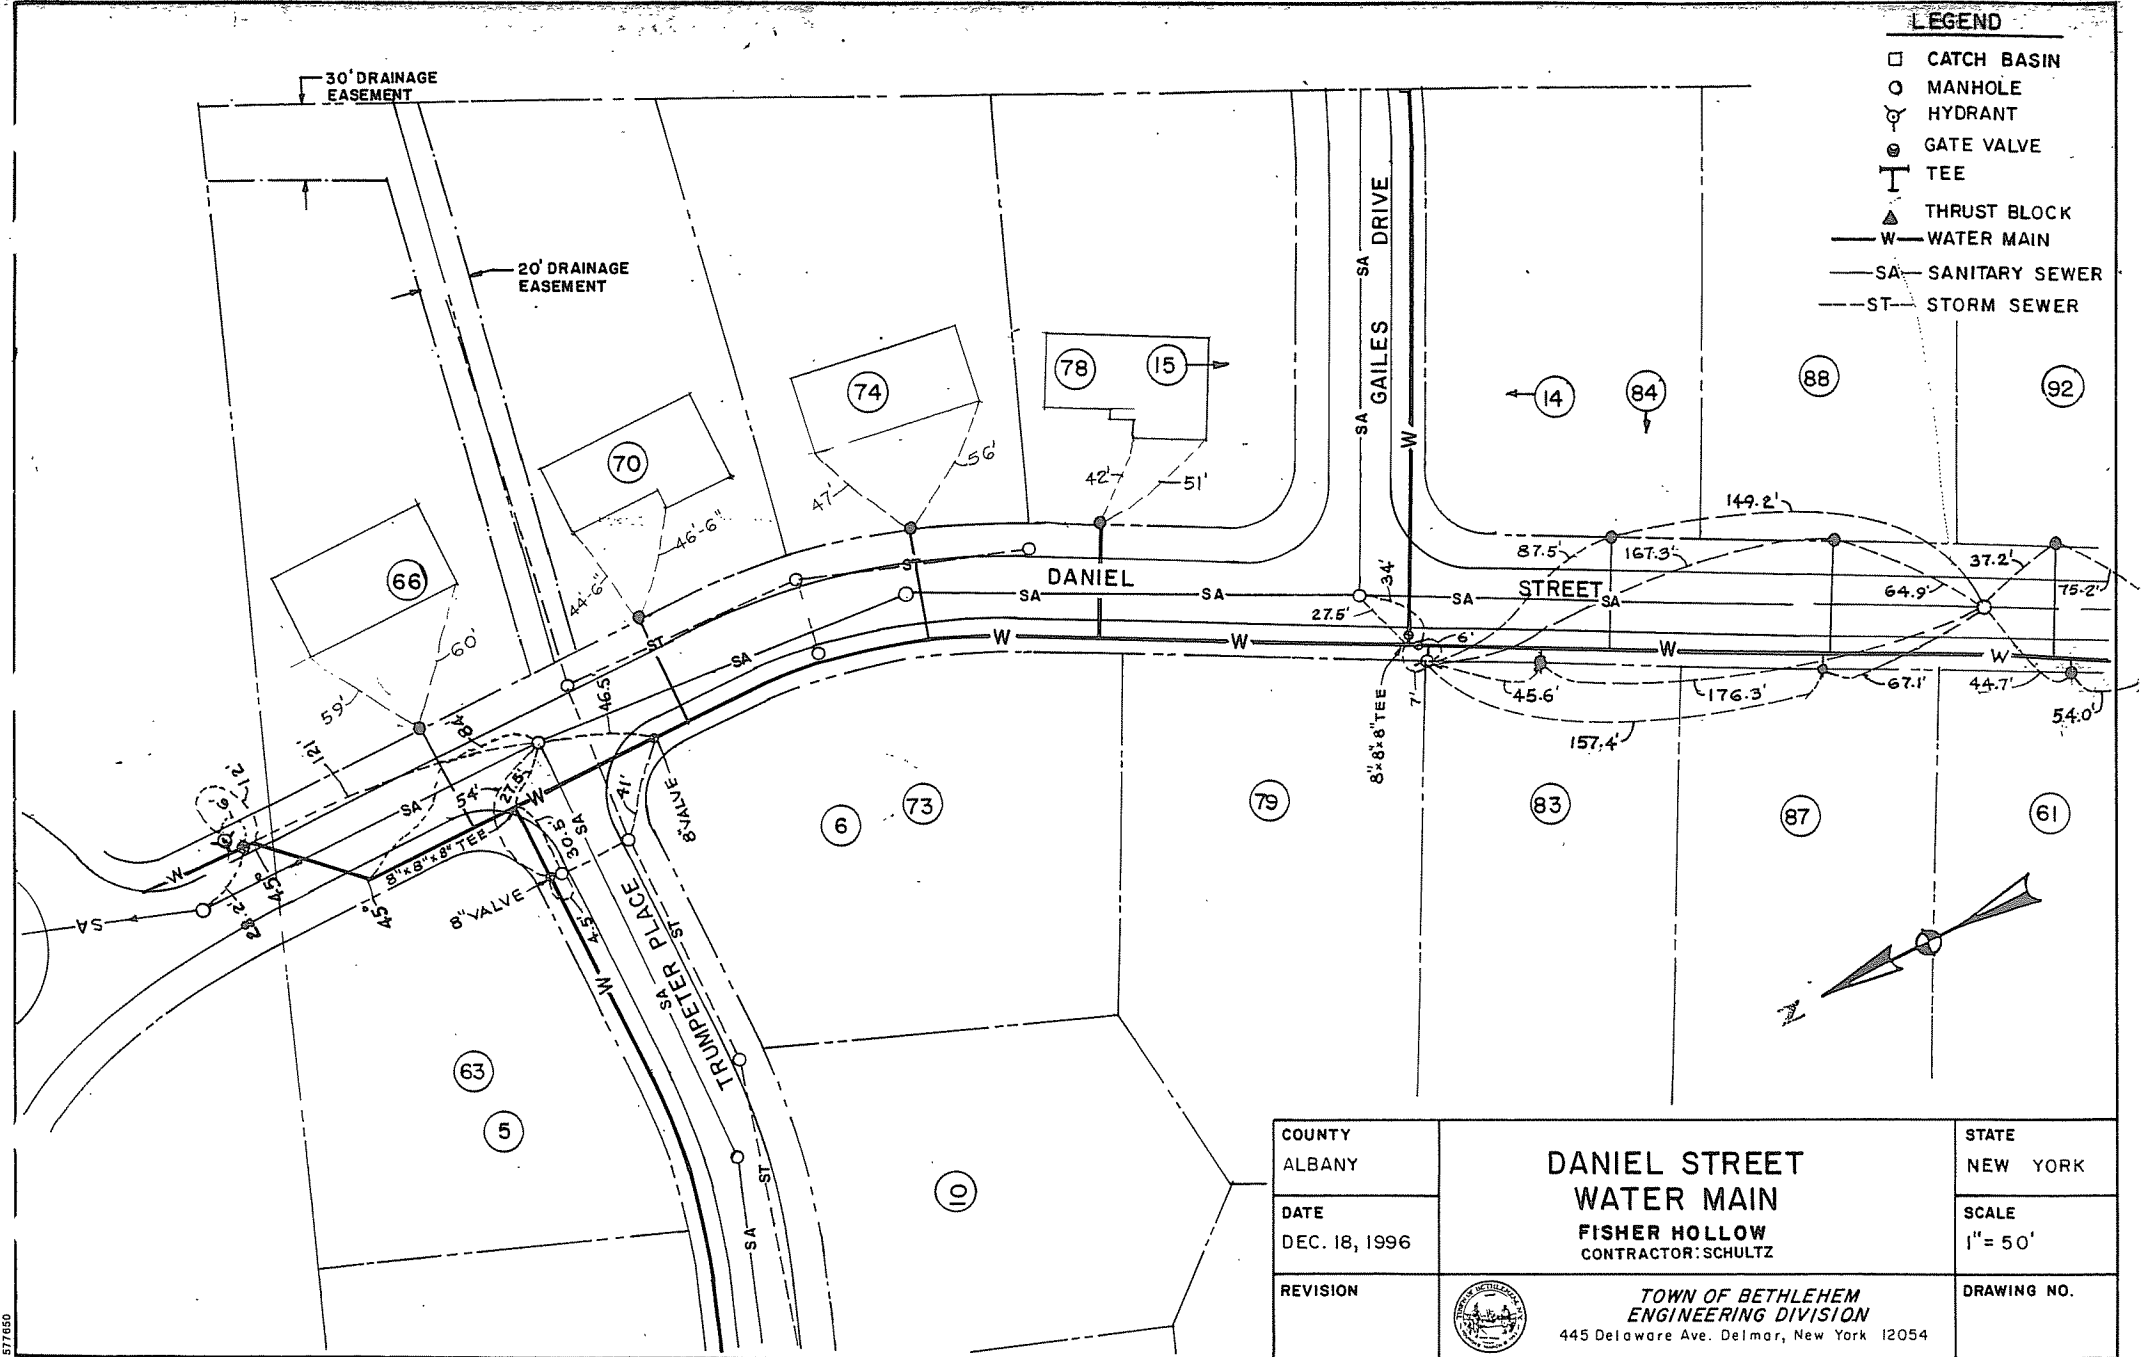

COUNTY ALBANY	DANIEL STREET WATER MAIN FISHER HOLLOW CONTRACTOR: SCHULTZ	STATE NEW YORK
DATE DEC. 18, 1996		SCALE 1" = 50'
REVISION	 TOWN OF BETHLEHEM ENGINEERING DIVISION 445 Delaware Ave. Delmar, New York 12054	DRAWING NO.

FISHER HOLLOW

577650