


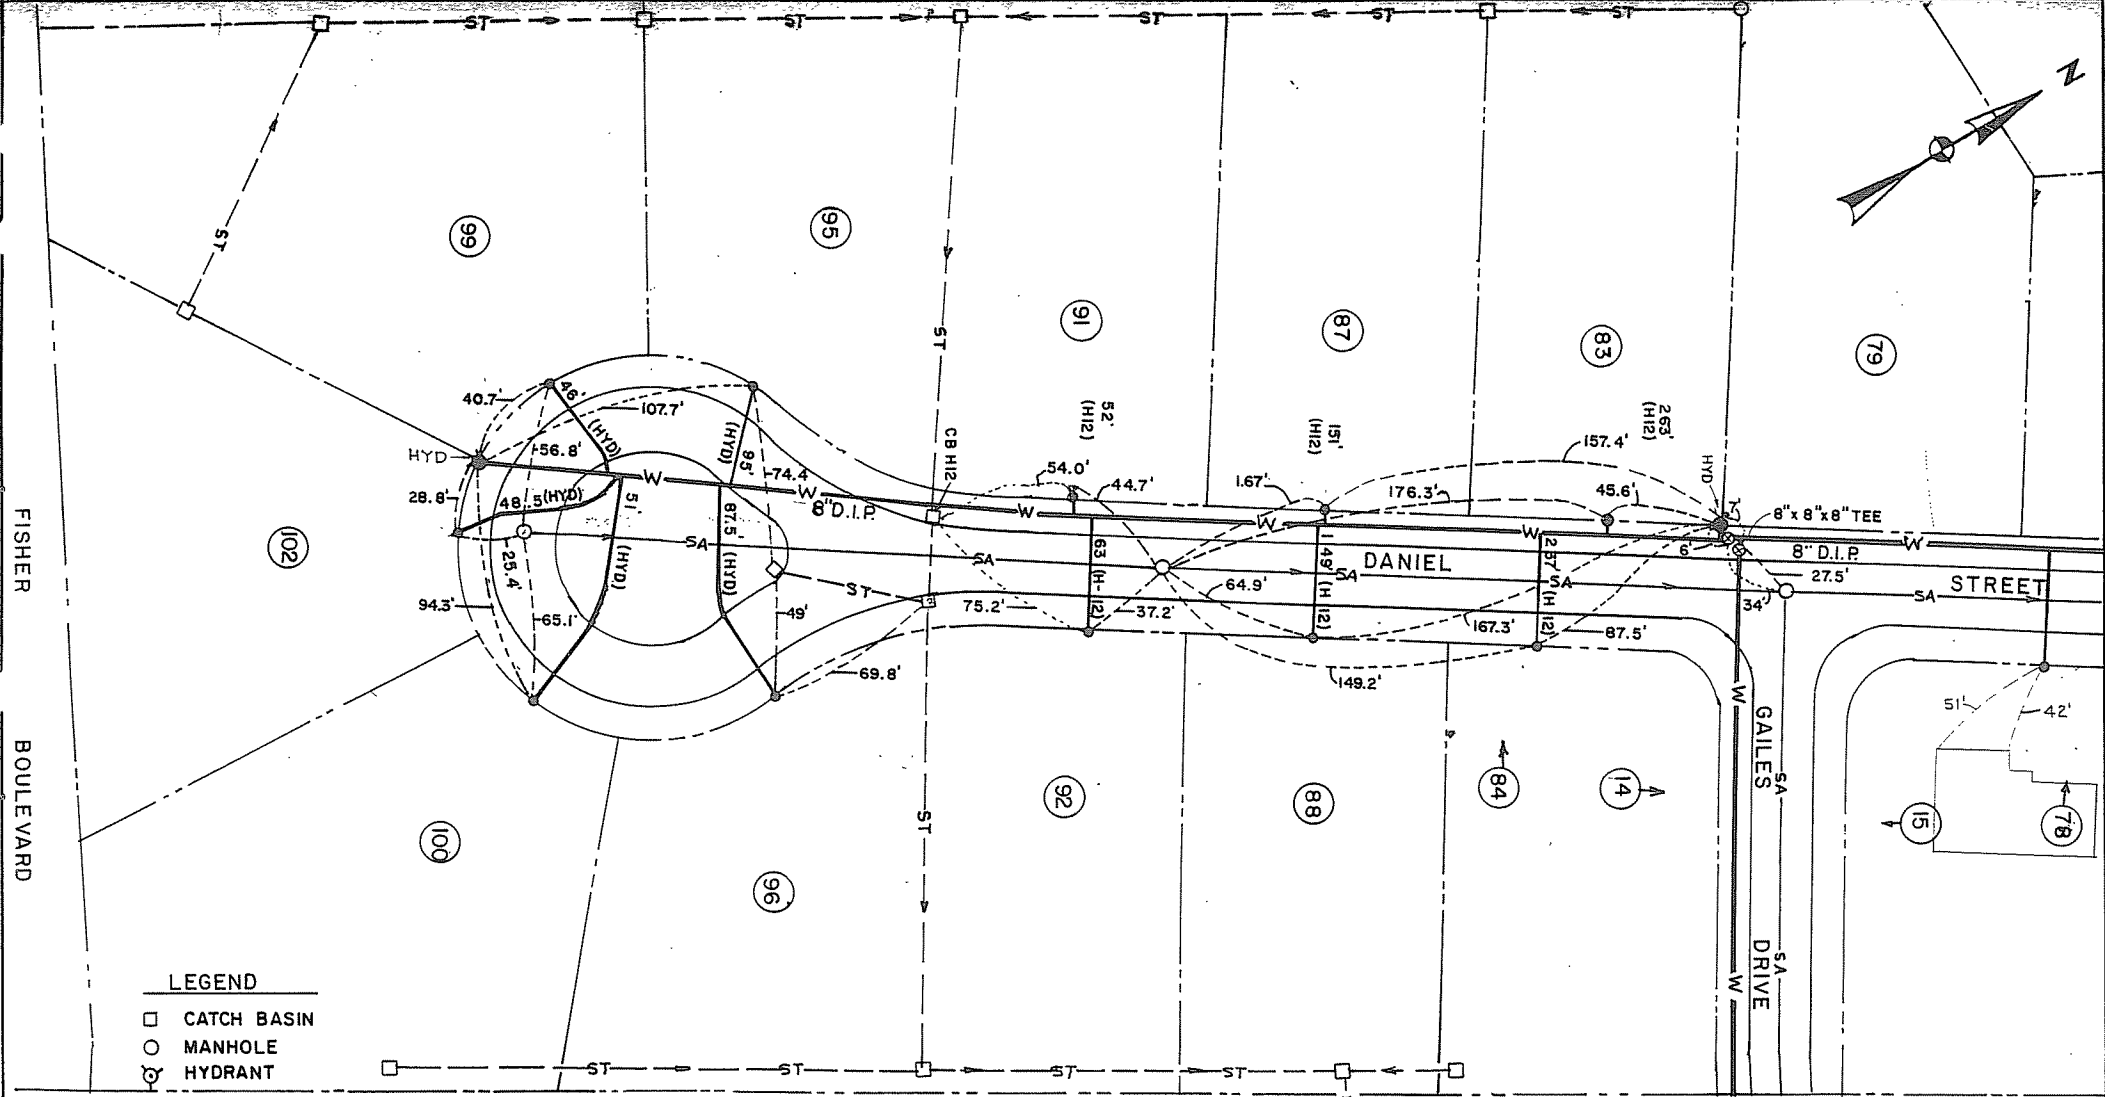

LEGEND

- CATCH BASIN
- MANHOLE
- ⊗ HYDRANT
- ⊗ GATE VALVE
- ⊥ TEE
- ▲ THRUST BLOCK
- W — WATER MAIN
- SA — SANITARY SEWER
- ST — STORM SEWER
- CURB BOX

COUNTY ALBANY	DANIEL STREET WATER MAIN FISHER HOLLOW CONTRACTOR: SCHULTZ	STATE NEW YORK
DATE JAN. 8, 1998		SCALE 1" = 50'
REVISION	 TOWN OF BETHLEHEM ENGINEERING DIVISION 445 Delaware Ave. Delmar, New York 12054	DRAWING NO.

M.G.

FISHER HOLLOW