

DARNLEY GREENE
WATER DISTRICT NO. 1
TOWN OF BETHLEHEM
RECORD OF INSTALLATION
TOWN OF BETHLEHEM ENGINEERING
DEPARTMENT
SCALE: 1" = 50' DECEMBER, 1982
DWN. BY: PDH




CAROLANNE DRIVE

DARNLEY

GREENE

MURRAY AVENUE

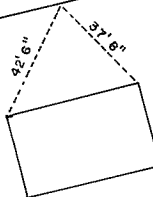

8

12

18

20

22

11

15

23