


DARNLEY GREENE  
WATER DISTRICT NO.1  
TOWN OF BETHLEHEM  
**RECORD OF INSTALLATION**  
TOWN OF BETHLEHEM ENGINEERING  
DEPARTMENT  
SCALE: 1"=50' DECEMBER, 1982  
DWN. BY: PDH

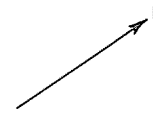

MURRAY

49

45

41

33

28

DARNLEY

GREENE

AVENUE

32

42

38

34

CITY

OF

ALBANY