


DARROCH ROAD
WATER DISTRICT NO.1
TOWN OF BETHLEHEM

RECORD OF INSTALLATION
TOWN OF BETHLEHEM ENGINEERING
DEPARTMENT


SCALE: 1" = 50' DECEMBER, 1982

DWN. BY: PDH

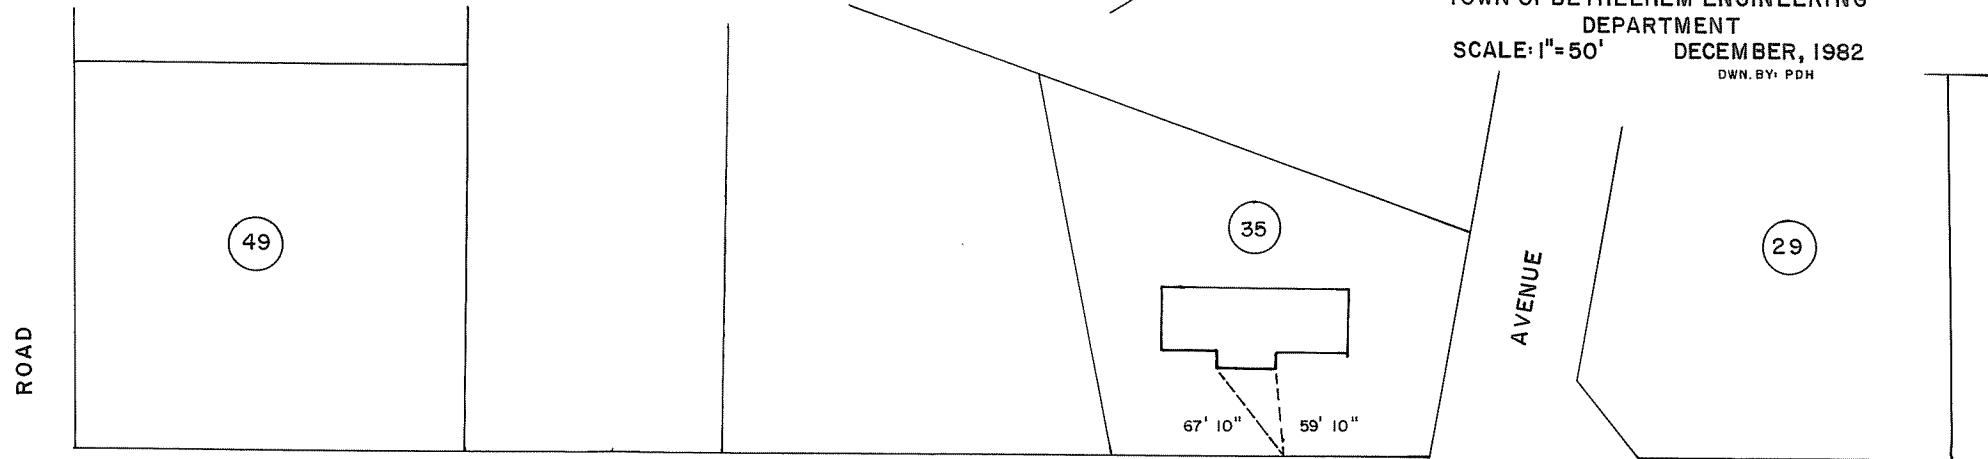

DARROCH

ROAD

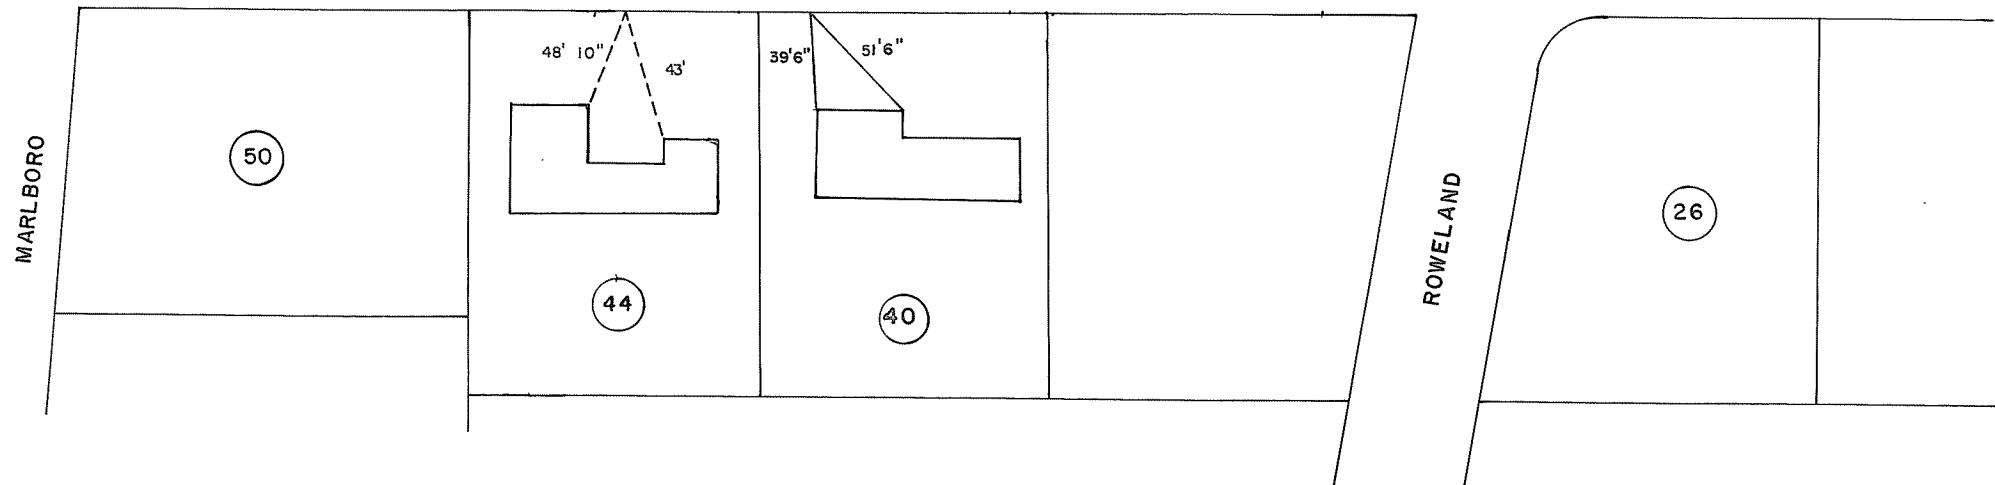

MARLBORO

ROWELAND