



DARROCH ROAD  
WATER DISTRICT NO.1  
TOWN OF BETHLEHEM  
RECORD OF INSTALLATION  
TOWN OF BETHLEHEM ENGINEERING  
DEPARTMENT  
SCALE: 1" = 50' DECEMBER, 1982  
DWN. BY: PDH

N

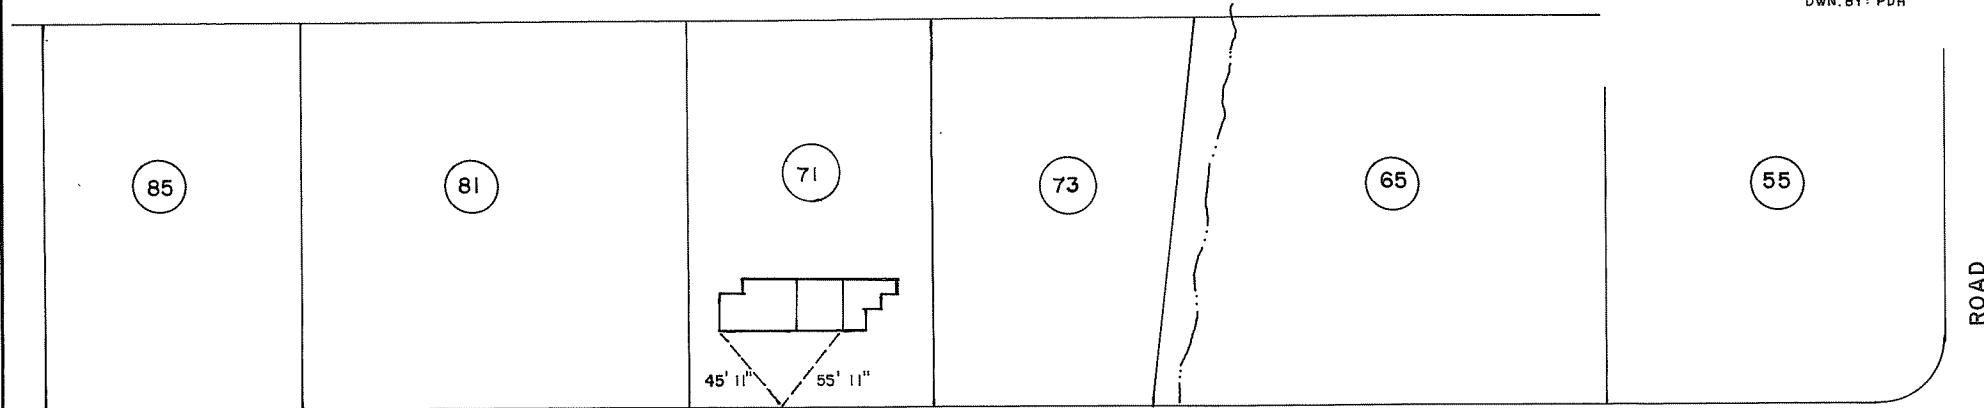

DARROCH

ROAD

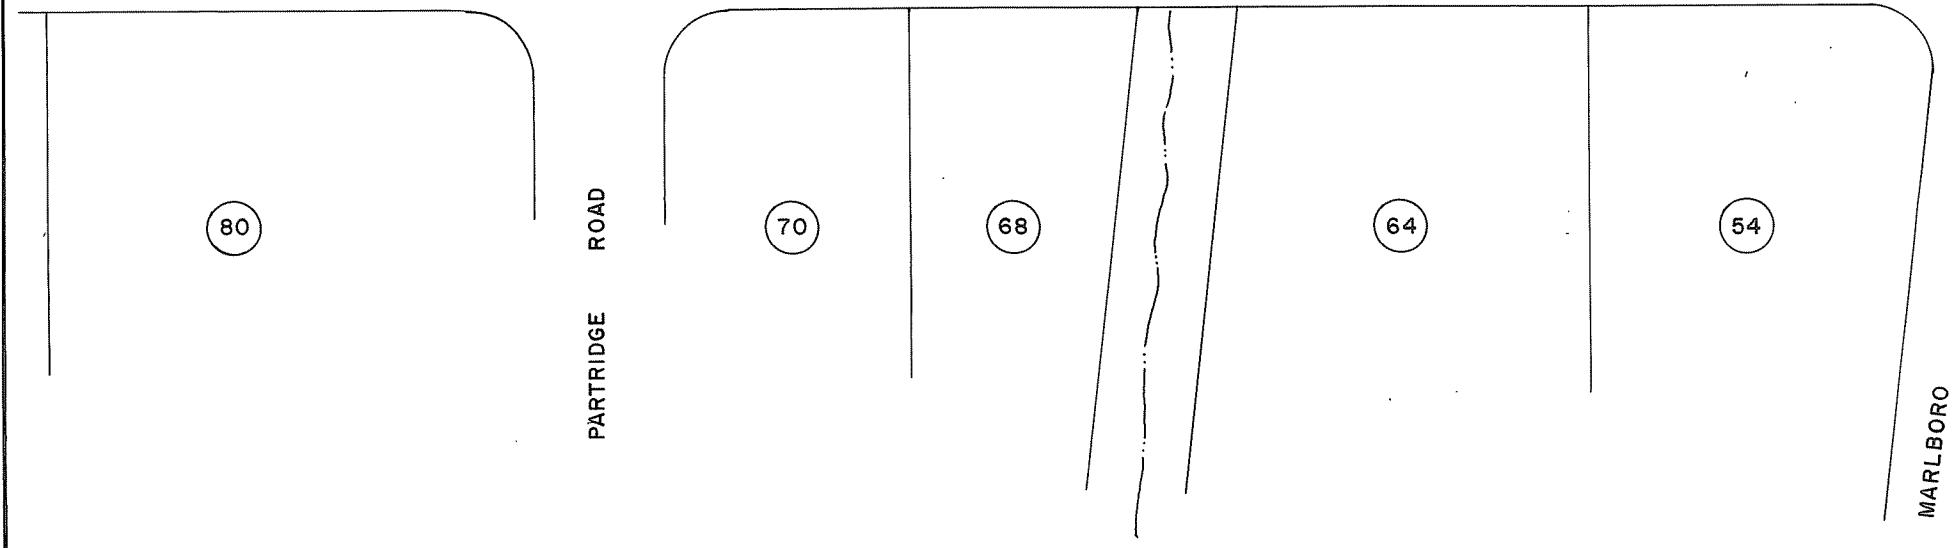

PARTRIDGE ROAD

MARLBORO