


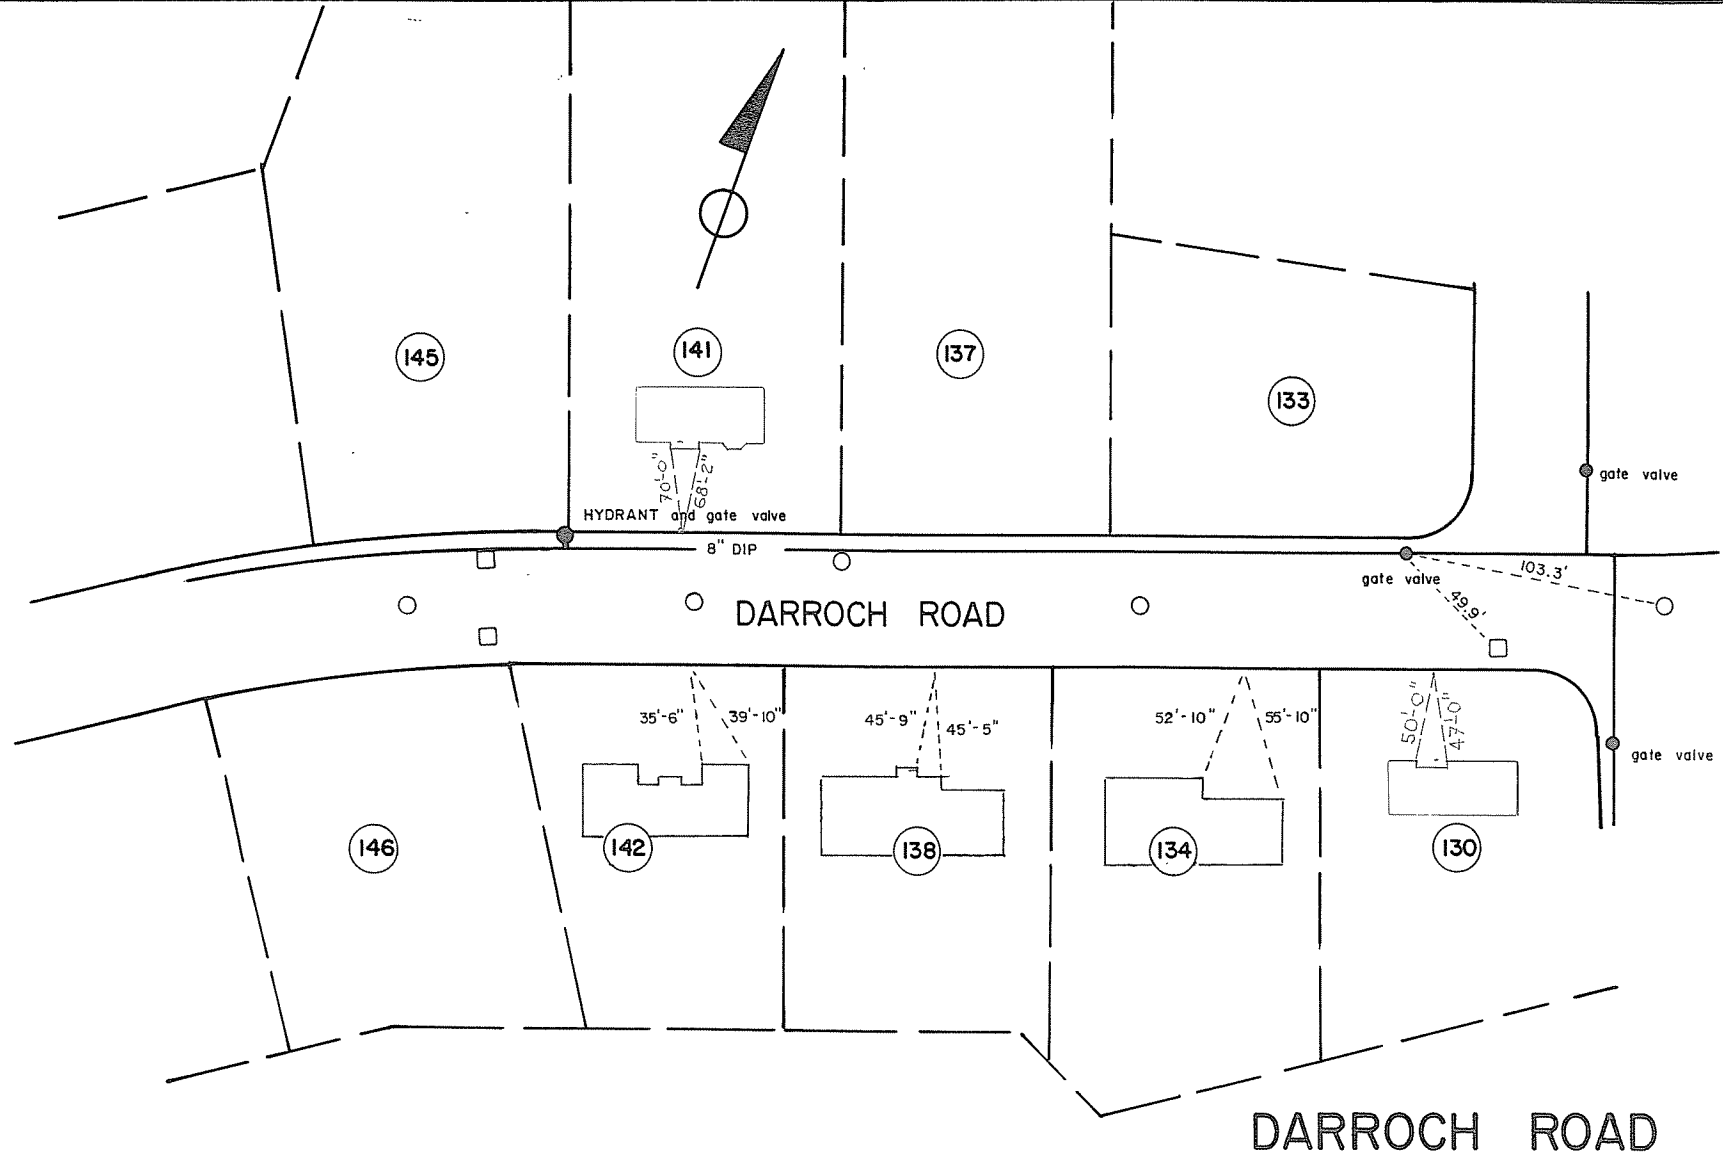

DARROCH ROAD

WATER MAINS
DECEMBER 1986

1" = 50'
TRINITY CONSTRUCTION