


LEGEND

- CATCH BASIN
- MANHOLE
- ⊙ HYDRANT
- ⊕ GATE VALVE
- T TEE
- ▲ THRUST BLOCK
- W— WATER MAIN

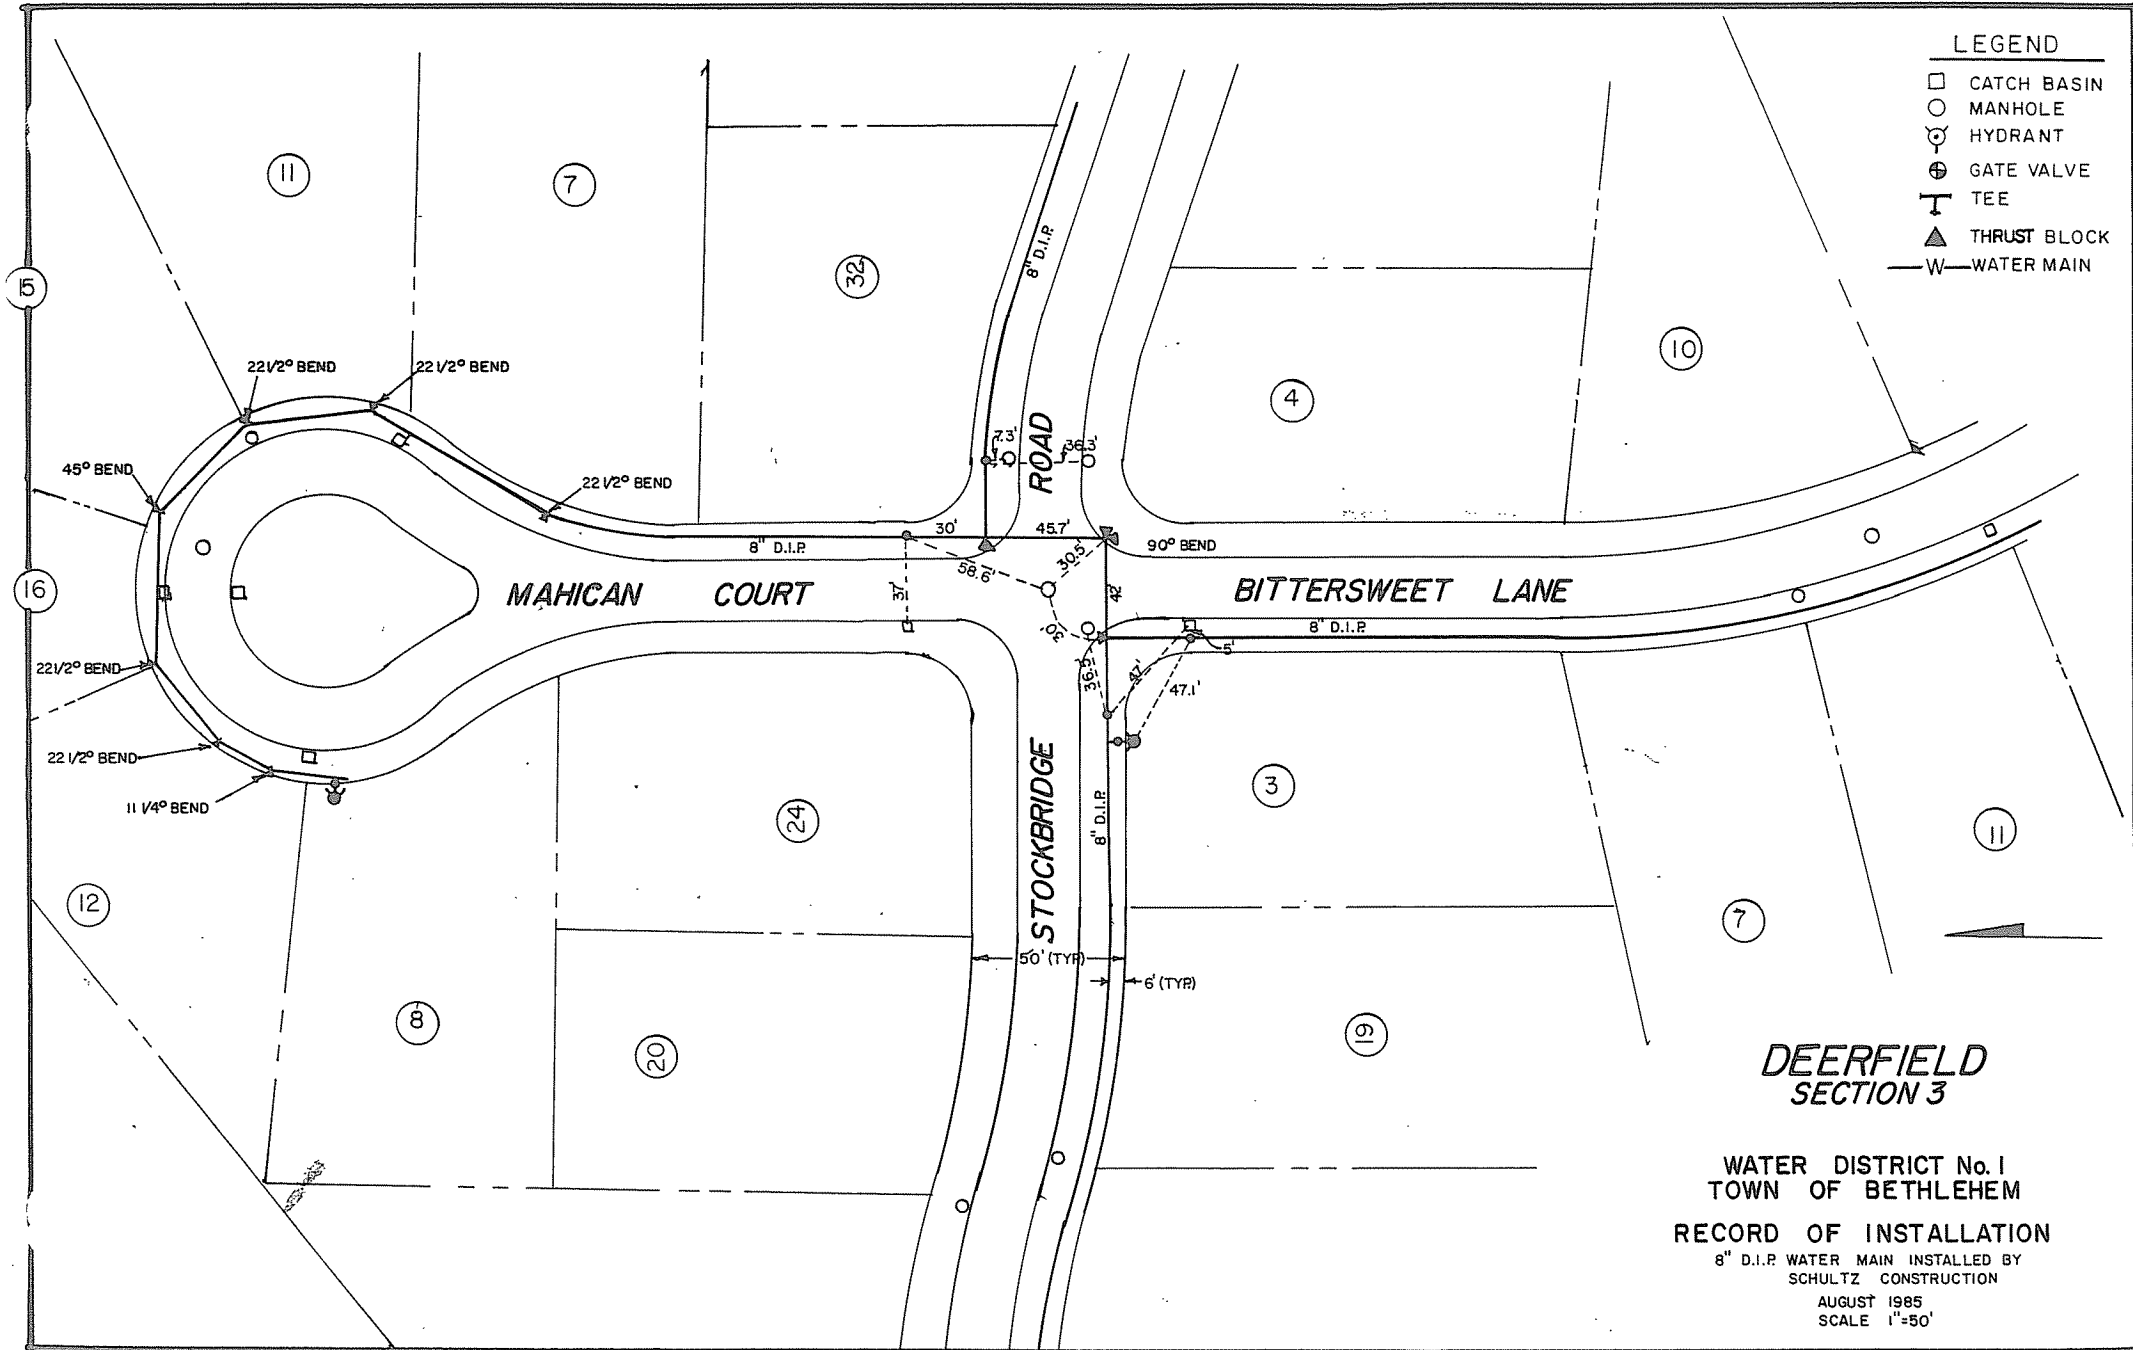

**DEERFIELD
SECTION 3**

WATER DISTRICT No. 1
TOWN OF BETHLEHEM
RECORD OF INSTALLATION
8" D.I.P. WATER MAIN INSTALLED BY
SCHULTZ CONSTRUCTION
AUGUST 1985
SCALE 1"=50'