


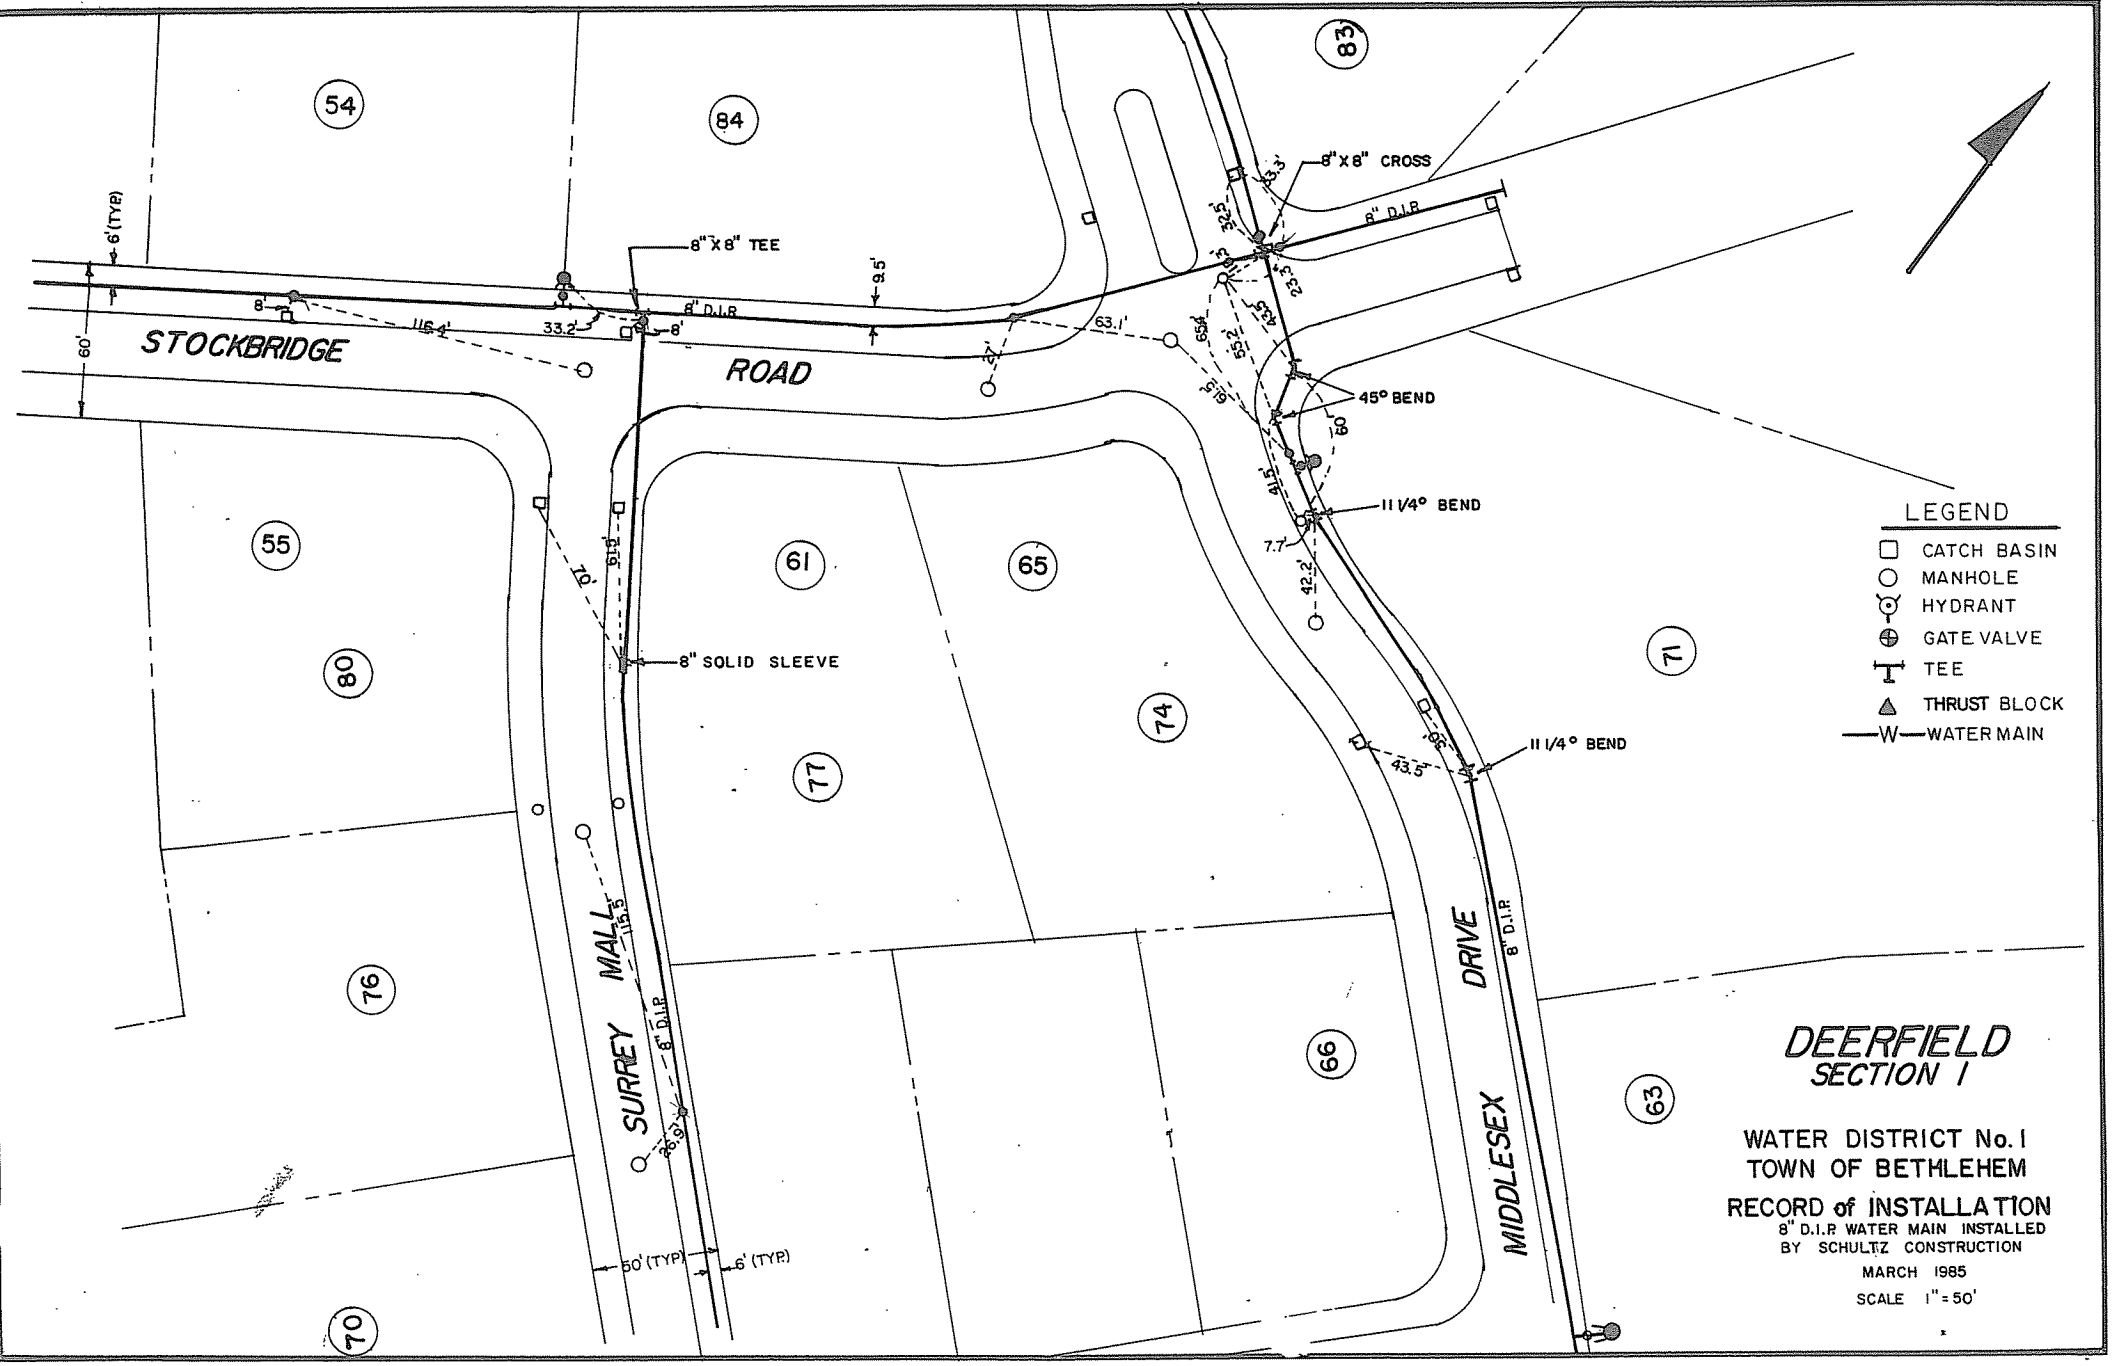

- LEGEND**
- CATCH BASIN
 - MANHOLE
 - HYDRANT
 - ⊕ GATE VALVE
 - T TEE
 - ▲ THRUST BLOCK
 - W— WATER MAIN

**DEERFIELD
SECTION 1**

WATER DISTRICT No. 1
TOWN OF BETHLEHEM
RECORD of INSTALLATION
8" D.I.P. WATER MAIN INSTALLED
BY SCHULTZ CONSTRUCTION
MARCH 1985
SCALE 1" = 50'