


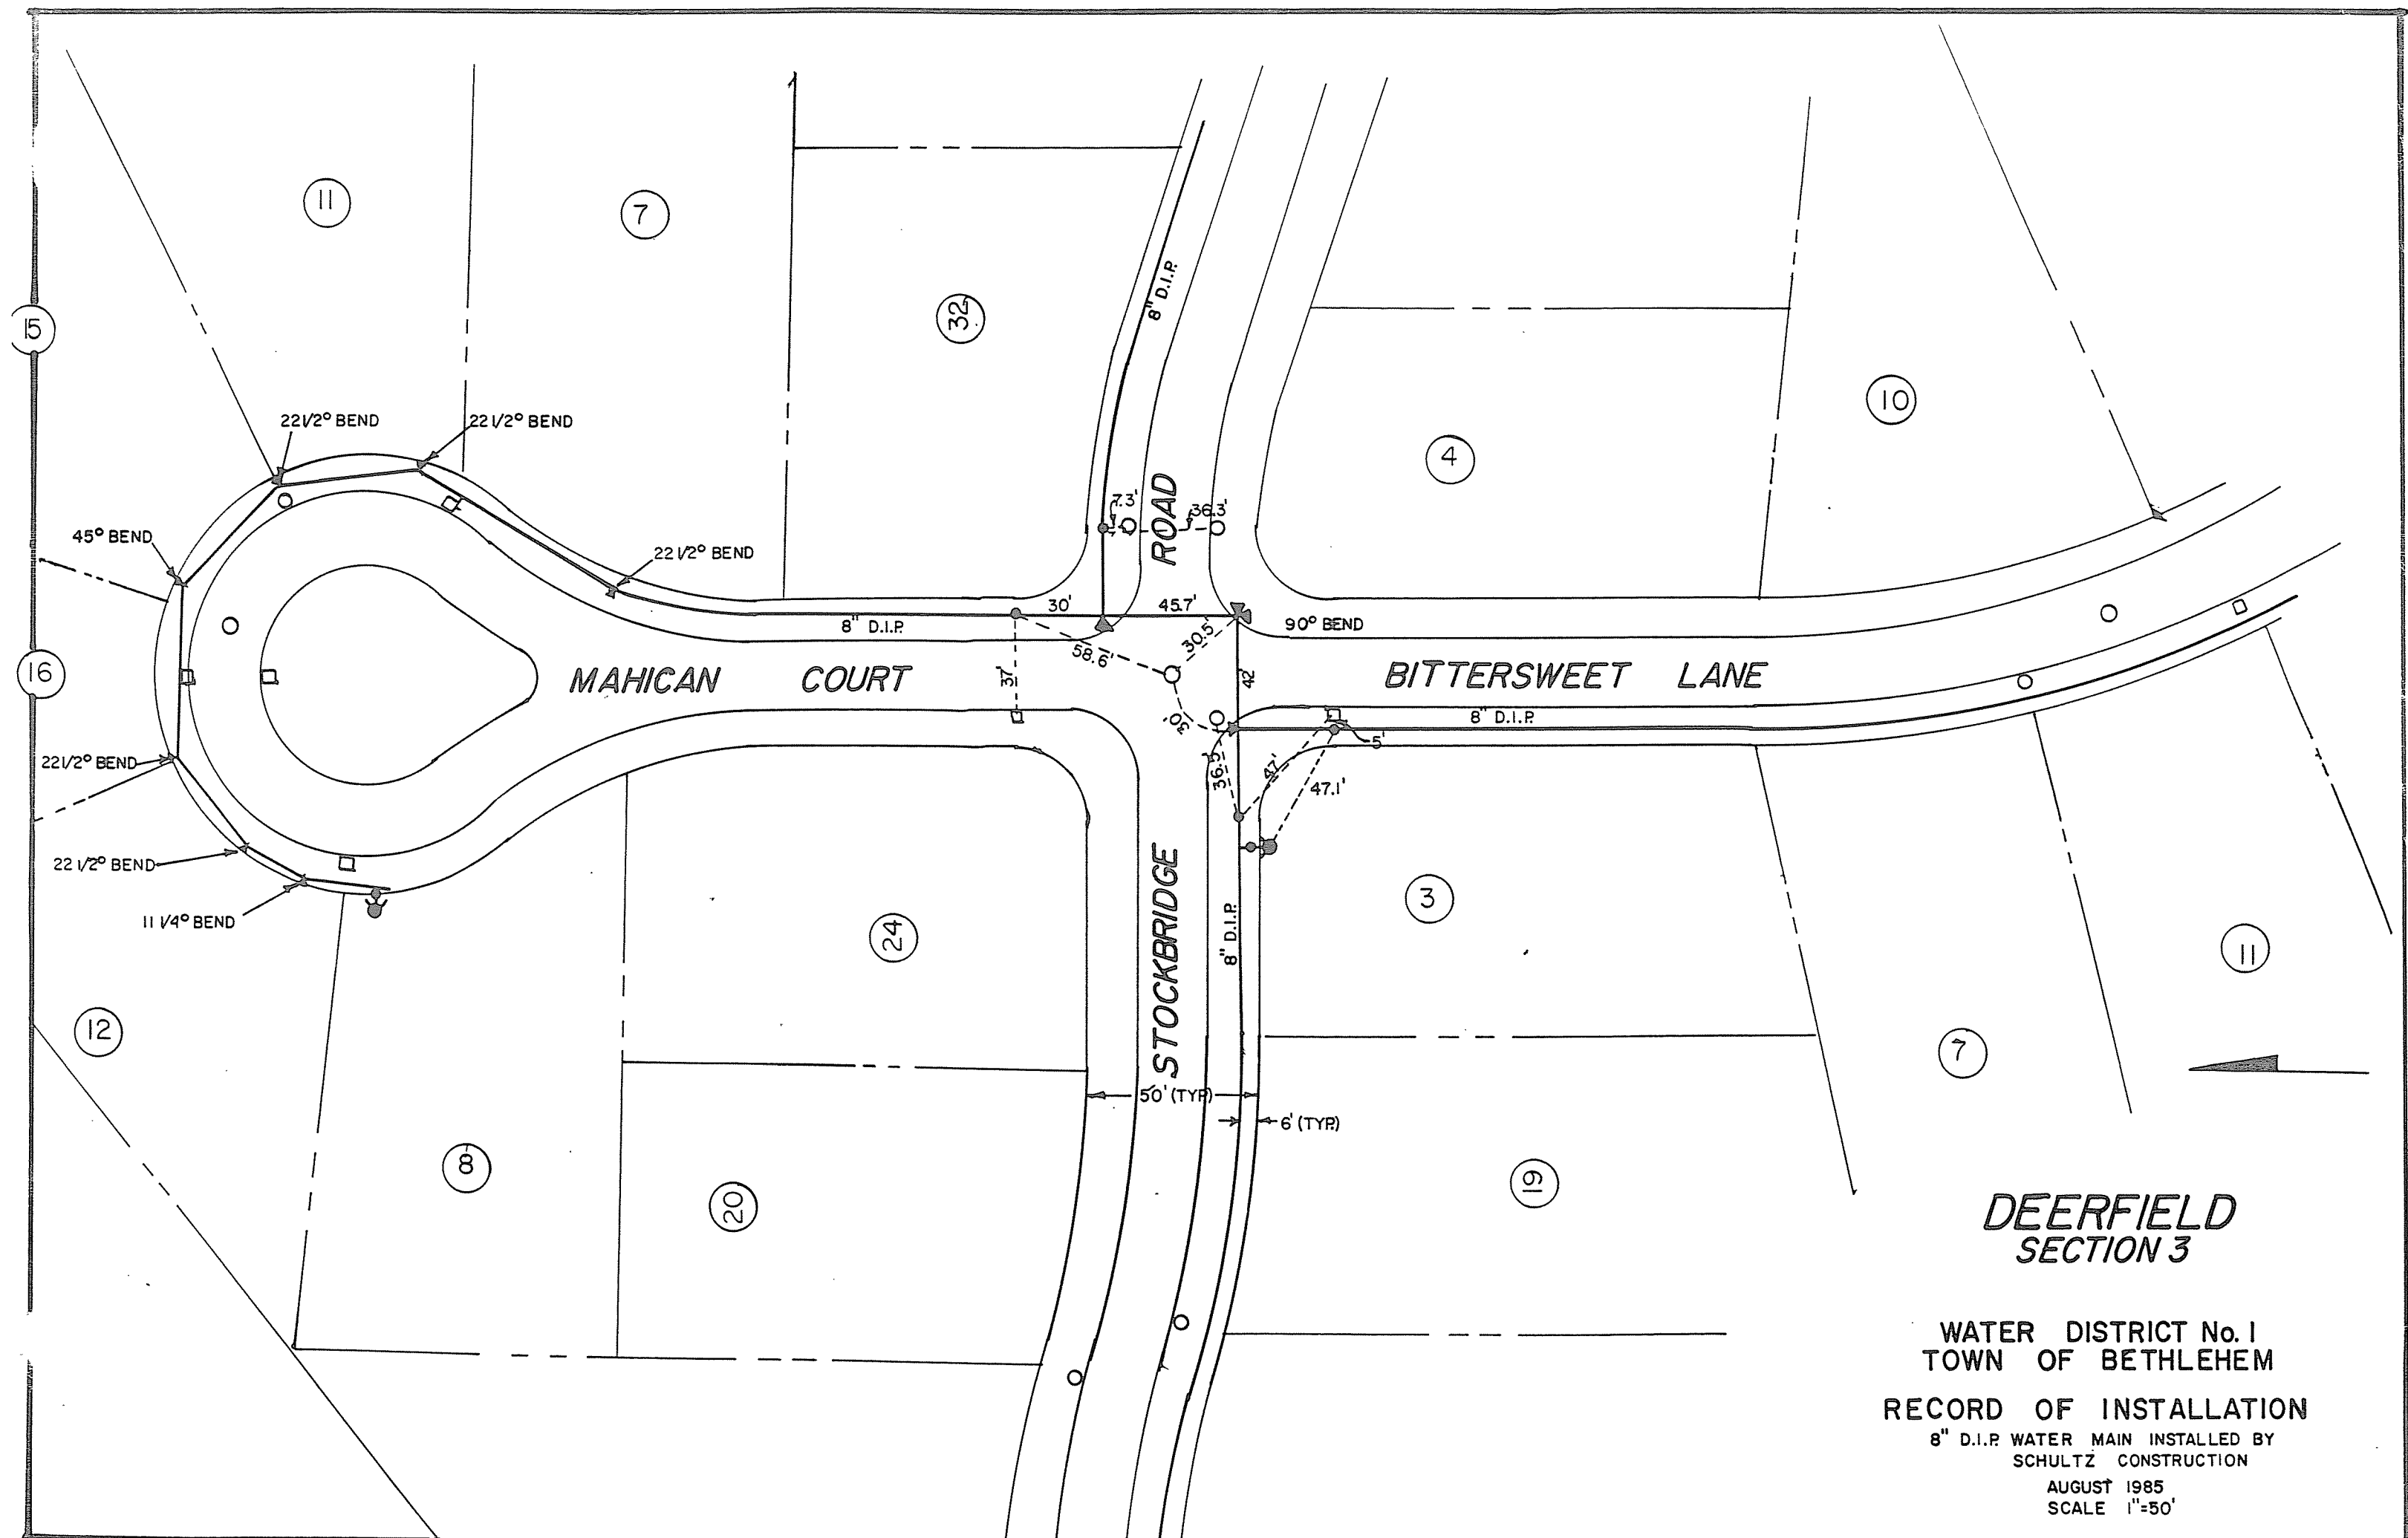

**DEERFIELD  
SECTION 3**

WATER DISTRICT No. 1  
TOWN OF BETHLEHEM  
**RECORD OF INSTALLATION**  
8" D.I.P. WATER MAIN INSTALLED BY  
SCHULTZ CONSTRUCTION  
AUGUST 1985  
SCALE 1"=50'