




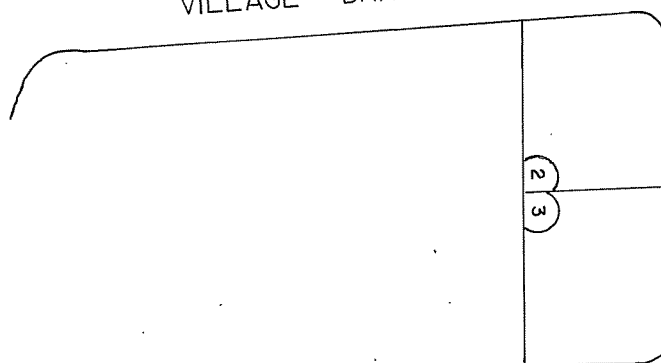

MINNOWBROOK AVENUE

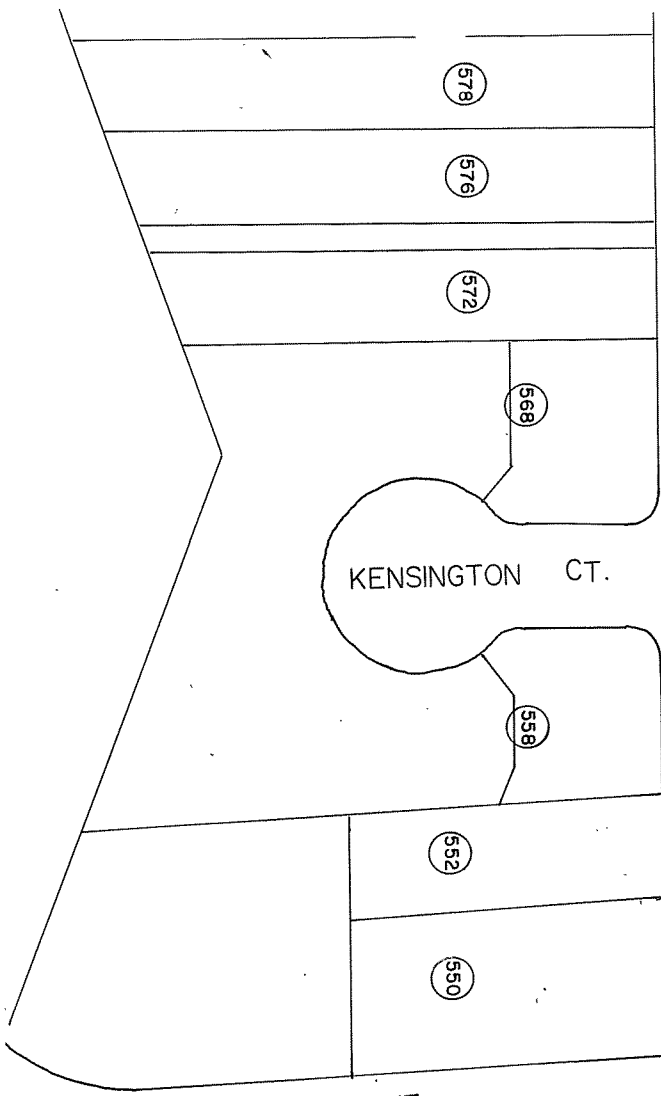

DELAWARE AVENUE

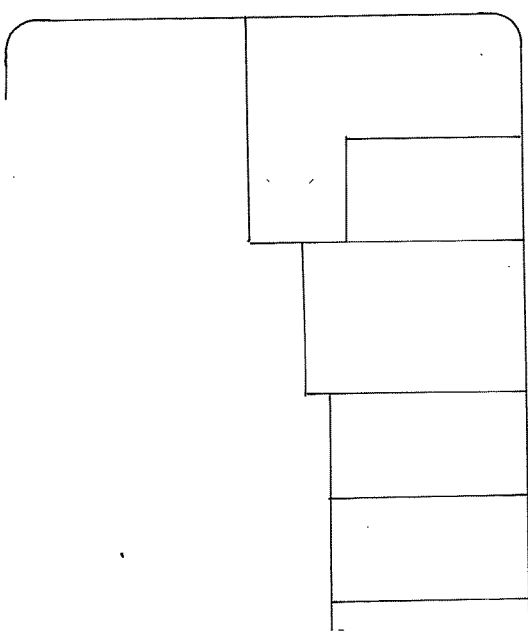