


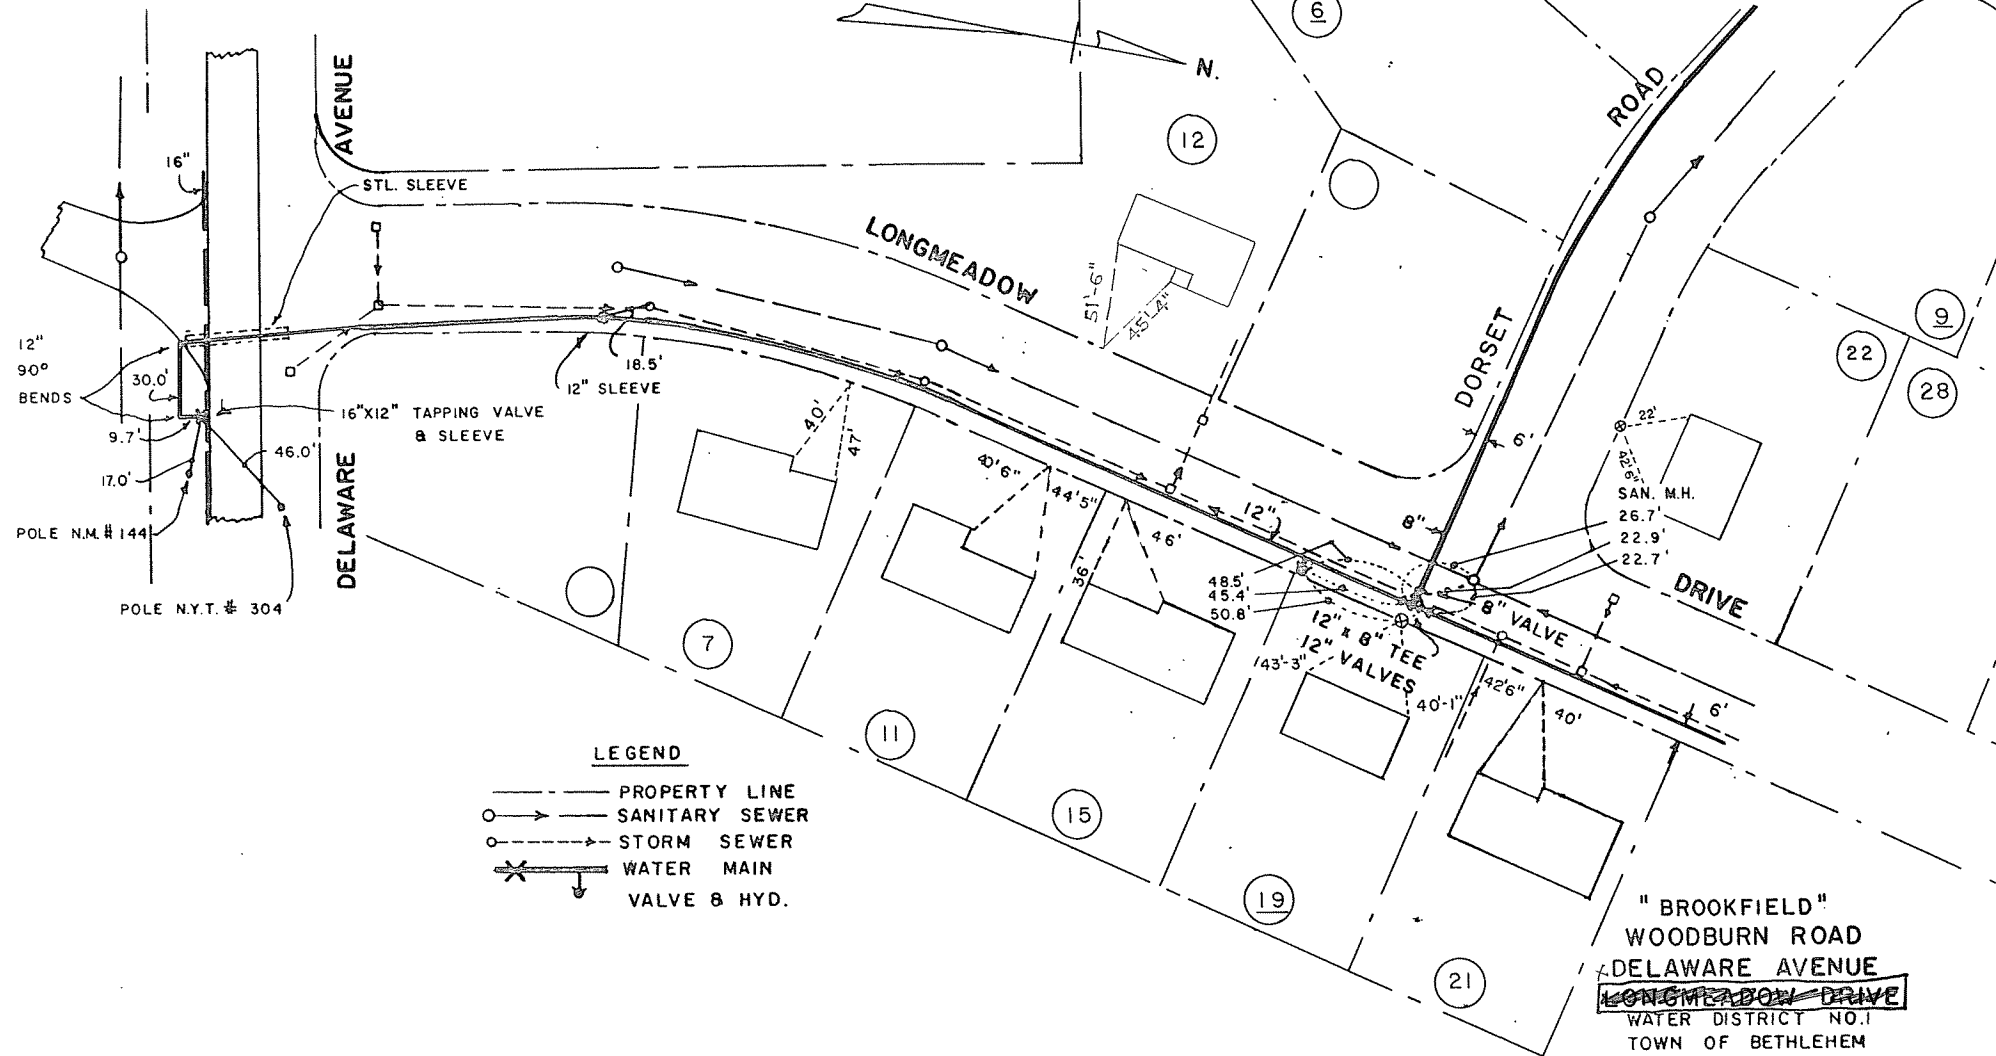

LEGEND

- PROPERTY LINE
- SANITARY SEWER
- - - STORM SEWER
- X — WATER MAIN
- VALVE & HYD.

"BROOKFIELD"
WOODBURN ROAD
DELAWARE AVENUE
~~LONGMEADOW DRIVE~~
WATER DISTRICT NO. 1
TOWN OF BETHLEHEM

RECORD OF INSTALLATIONS
J. KENNETH FRASER & ASSOCIATES, P.C.
CONSULTING ENGRS. RENSSELAER, N. Y.
SCALE 1" = 50' JULY 1978