


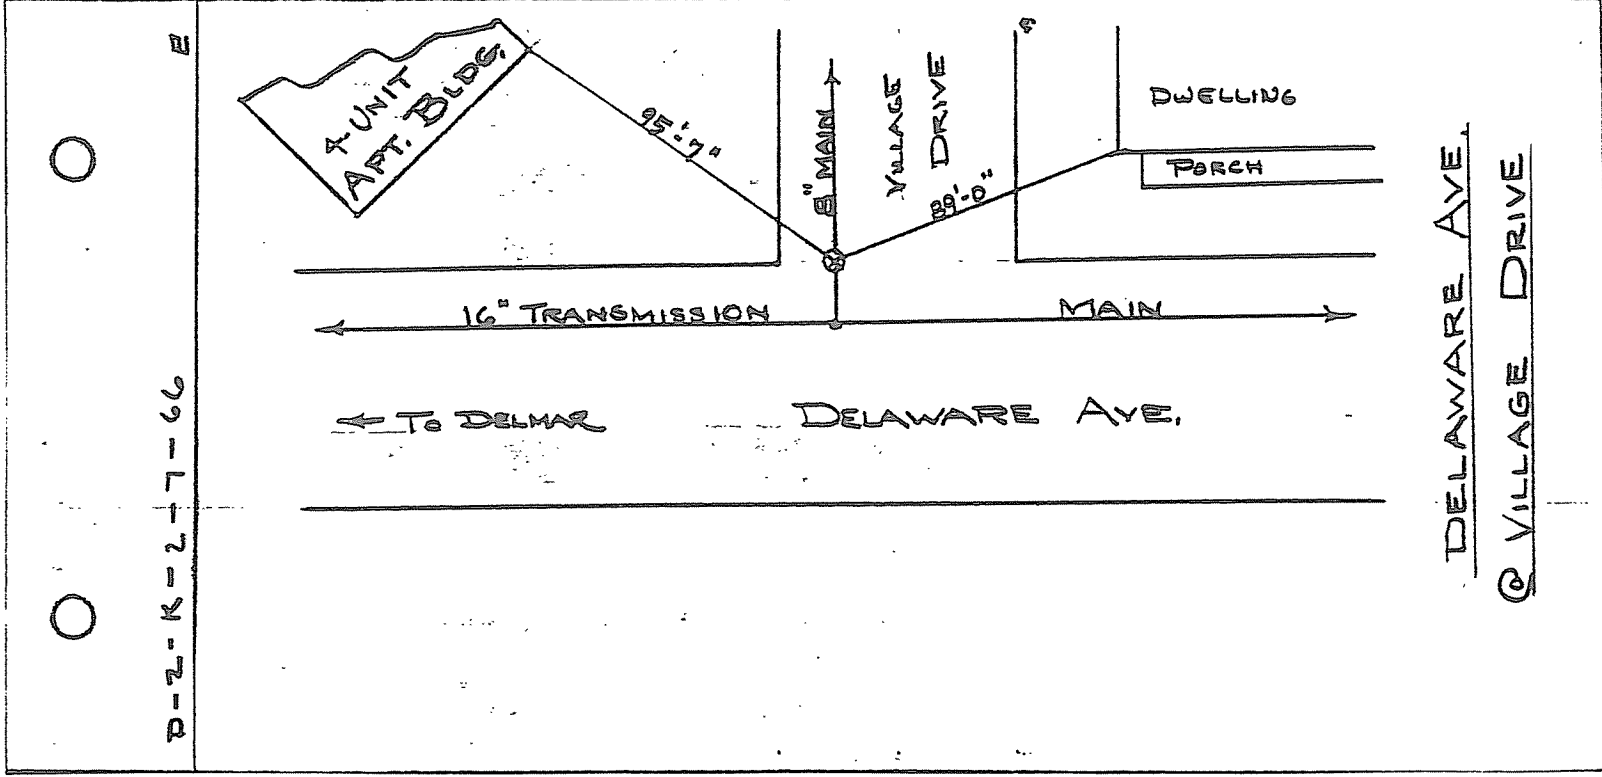

DELAWARE AVENUE

WATER MAIN