


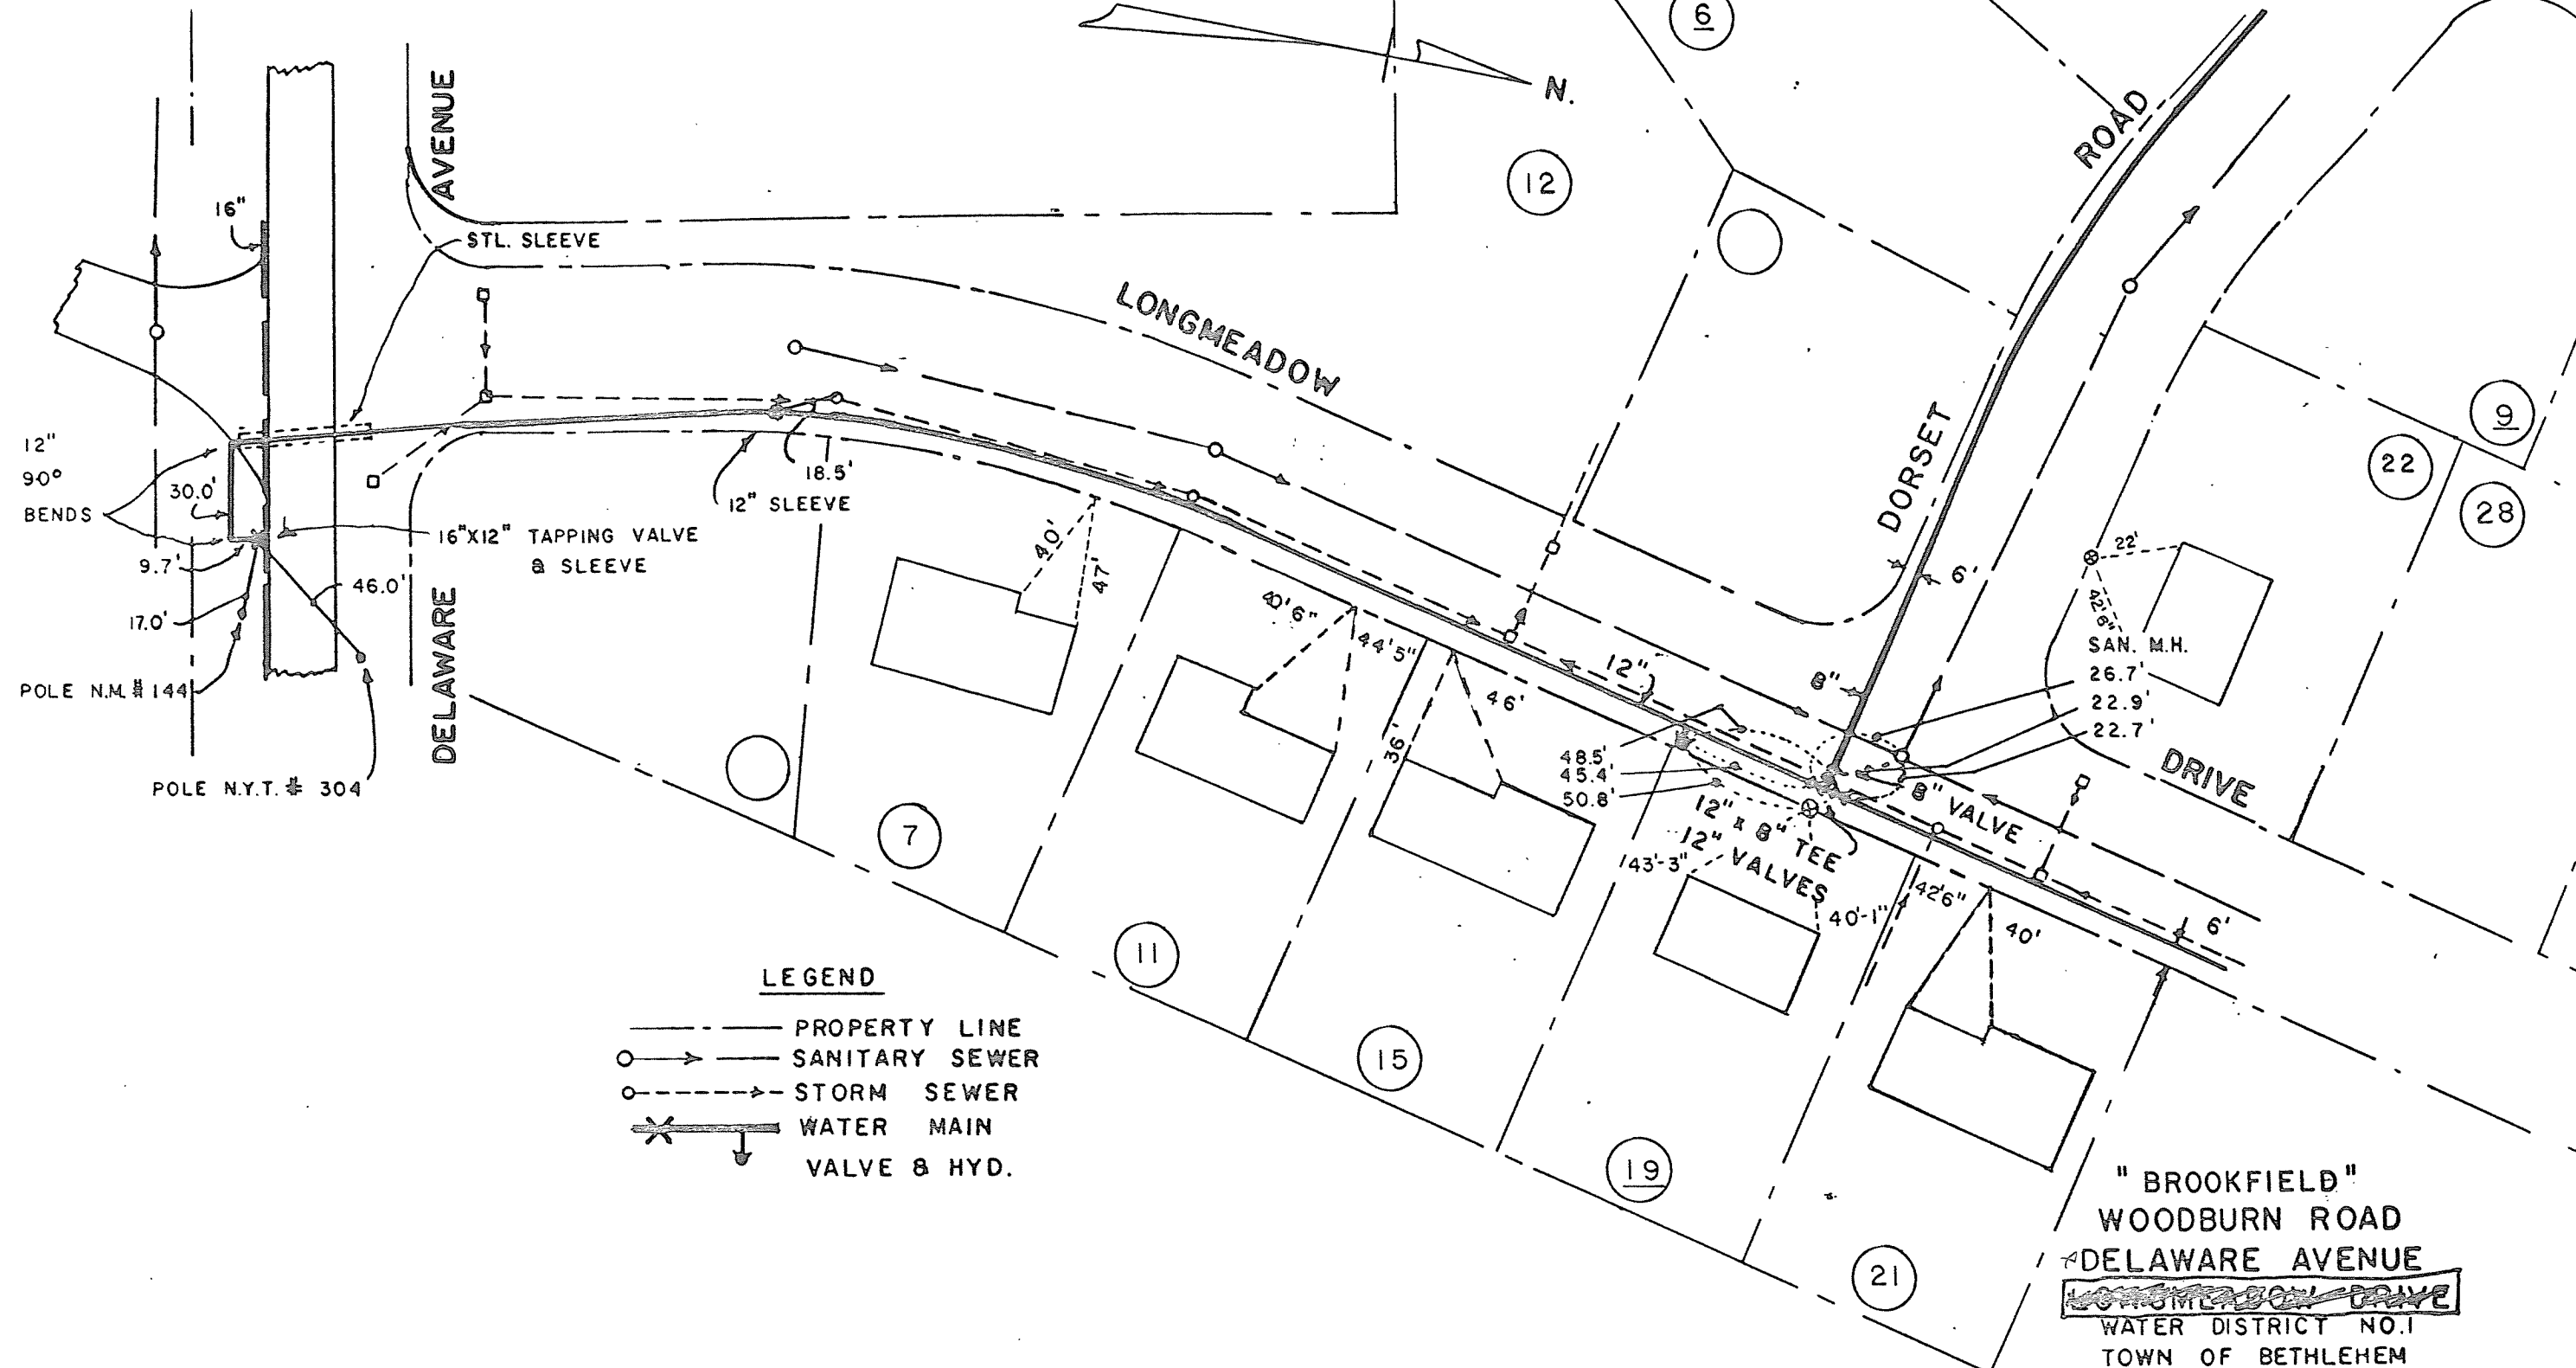

"BROOKFIELD"
WOODBURN ROAD
DELAWARE AVENUE
~~LONGMEADOW DRIVE~~
 WATER DISTRICT NO. 1
 TOWN OF BETHLEHEM

RECORD OF INSTALLATIONS
 J. KENNETH FRASER & ASSOCIATES, P.C.
 CONSULTING ENGRS. RENSSELAER, N.Y.
 SCALE 1" = 50' JULY 1978