


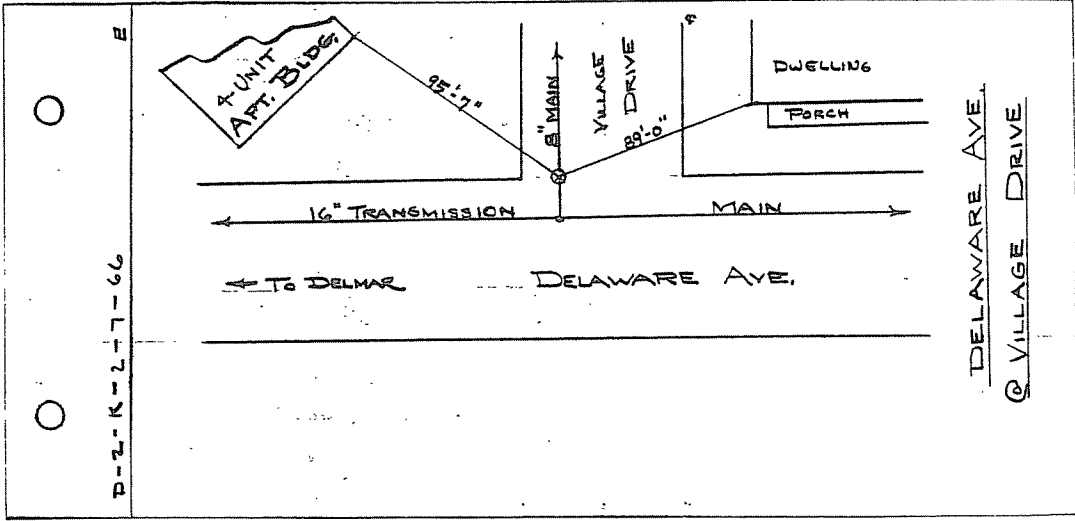

DELAWARE AVENUE
WATER MAIN