

LEGEND

- CATCH BASIN
- MANHOLE
- HYDRANT
- ⊕ GATE VALVE
- └ TEE
- △ THRUST BLOCK
- W—WATER MAIN



JUNIPER DRIVE

8" DIP

HYDRANT & GATE VALVE


92.6'

49.8'

DELMAR BYPASS EXT. + 16+00

8" GATE VALVE

10" GATE VALVES

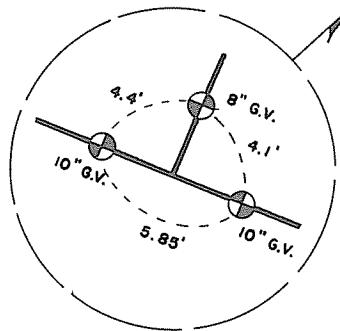

10" DIP  
APPROX. 6' OFF PROPERTY LINE

DELMAR BYPASS EXT.  
WATER MAINS  
9/88  
1" = 40'

TWR