


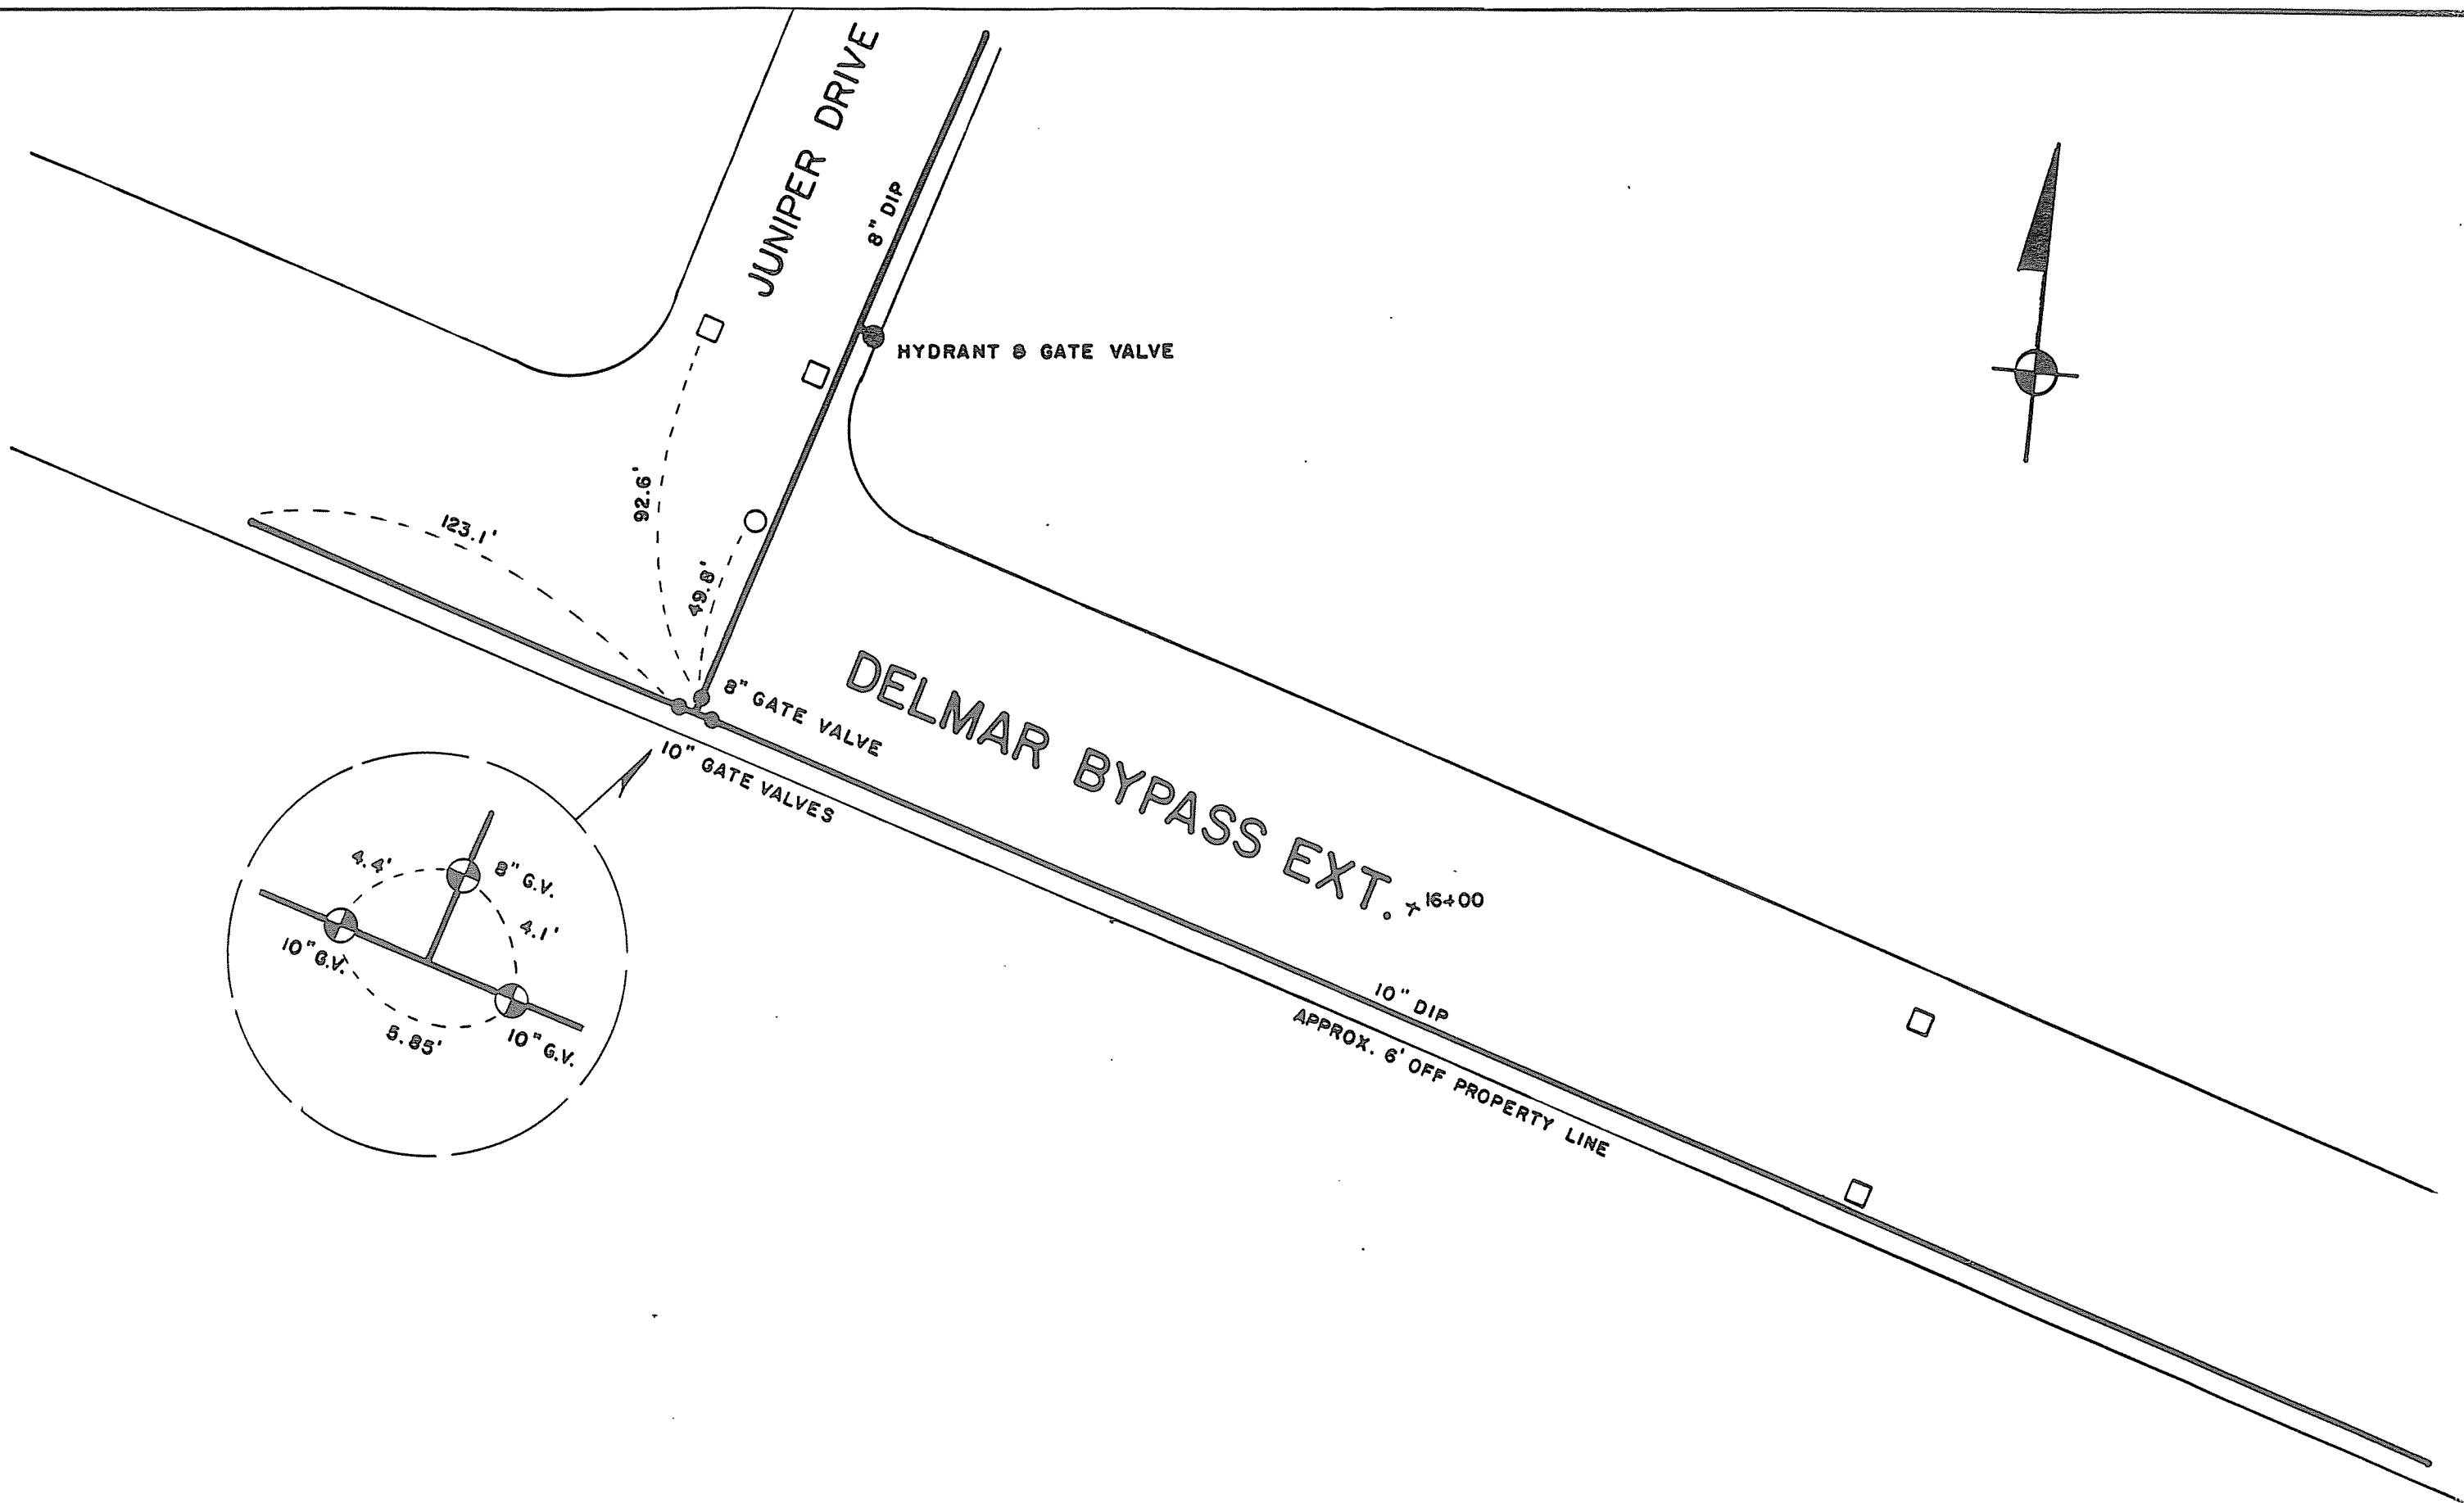

DELMAR BYPASS EXT.
WATER MAINS
9/88
1" = 40'