



DELMAR PLACE
WATER DISTRICT NO. 1
TOWN OF BETHLEHEM
RECORD OF INSTALLATION
TOWN OF BETHLEHEM ENGINEERING
DEPARTMENT
SCALE: 1"=50' FEBRUARY, 1982
DWN. BY: PDH

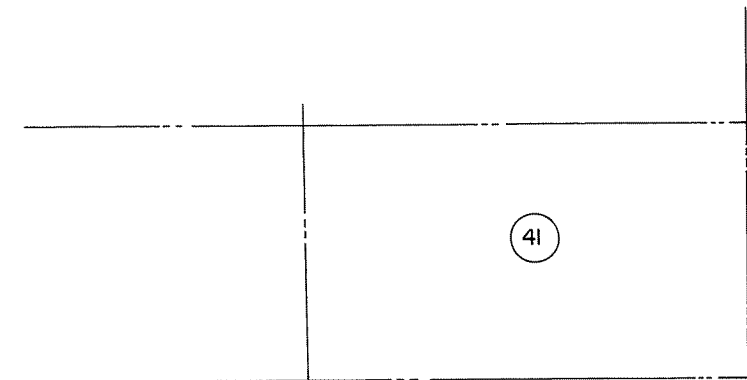

41

ROAD

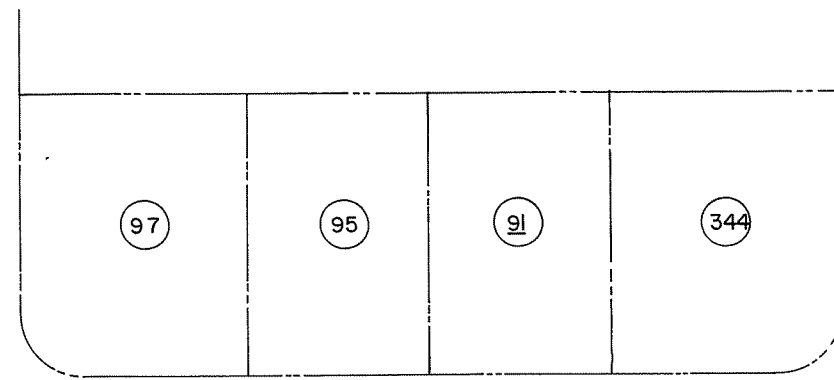

97

95


91

344

ROAD


DELMAR

PLACE

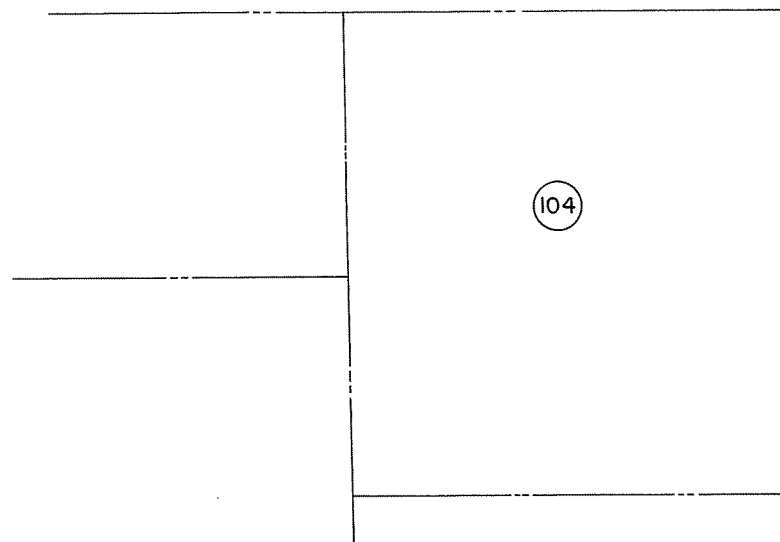

104

DOUGLAS

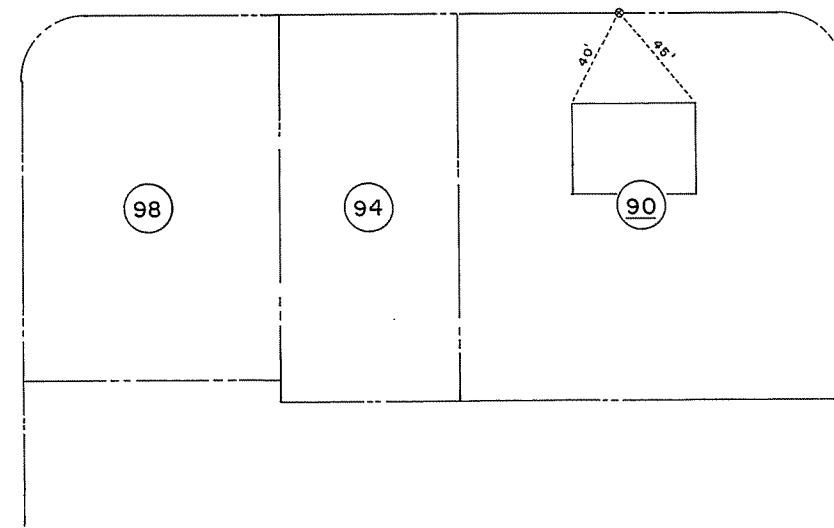

98

94

90

WELLINGTON