


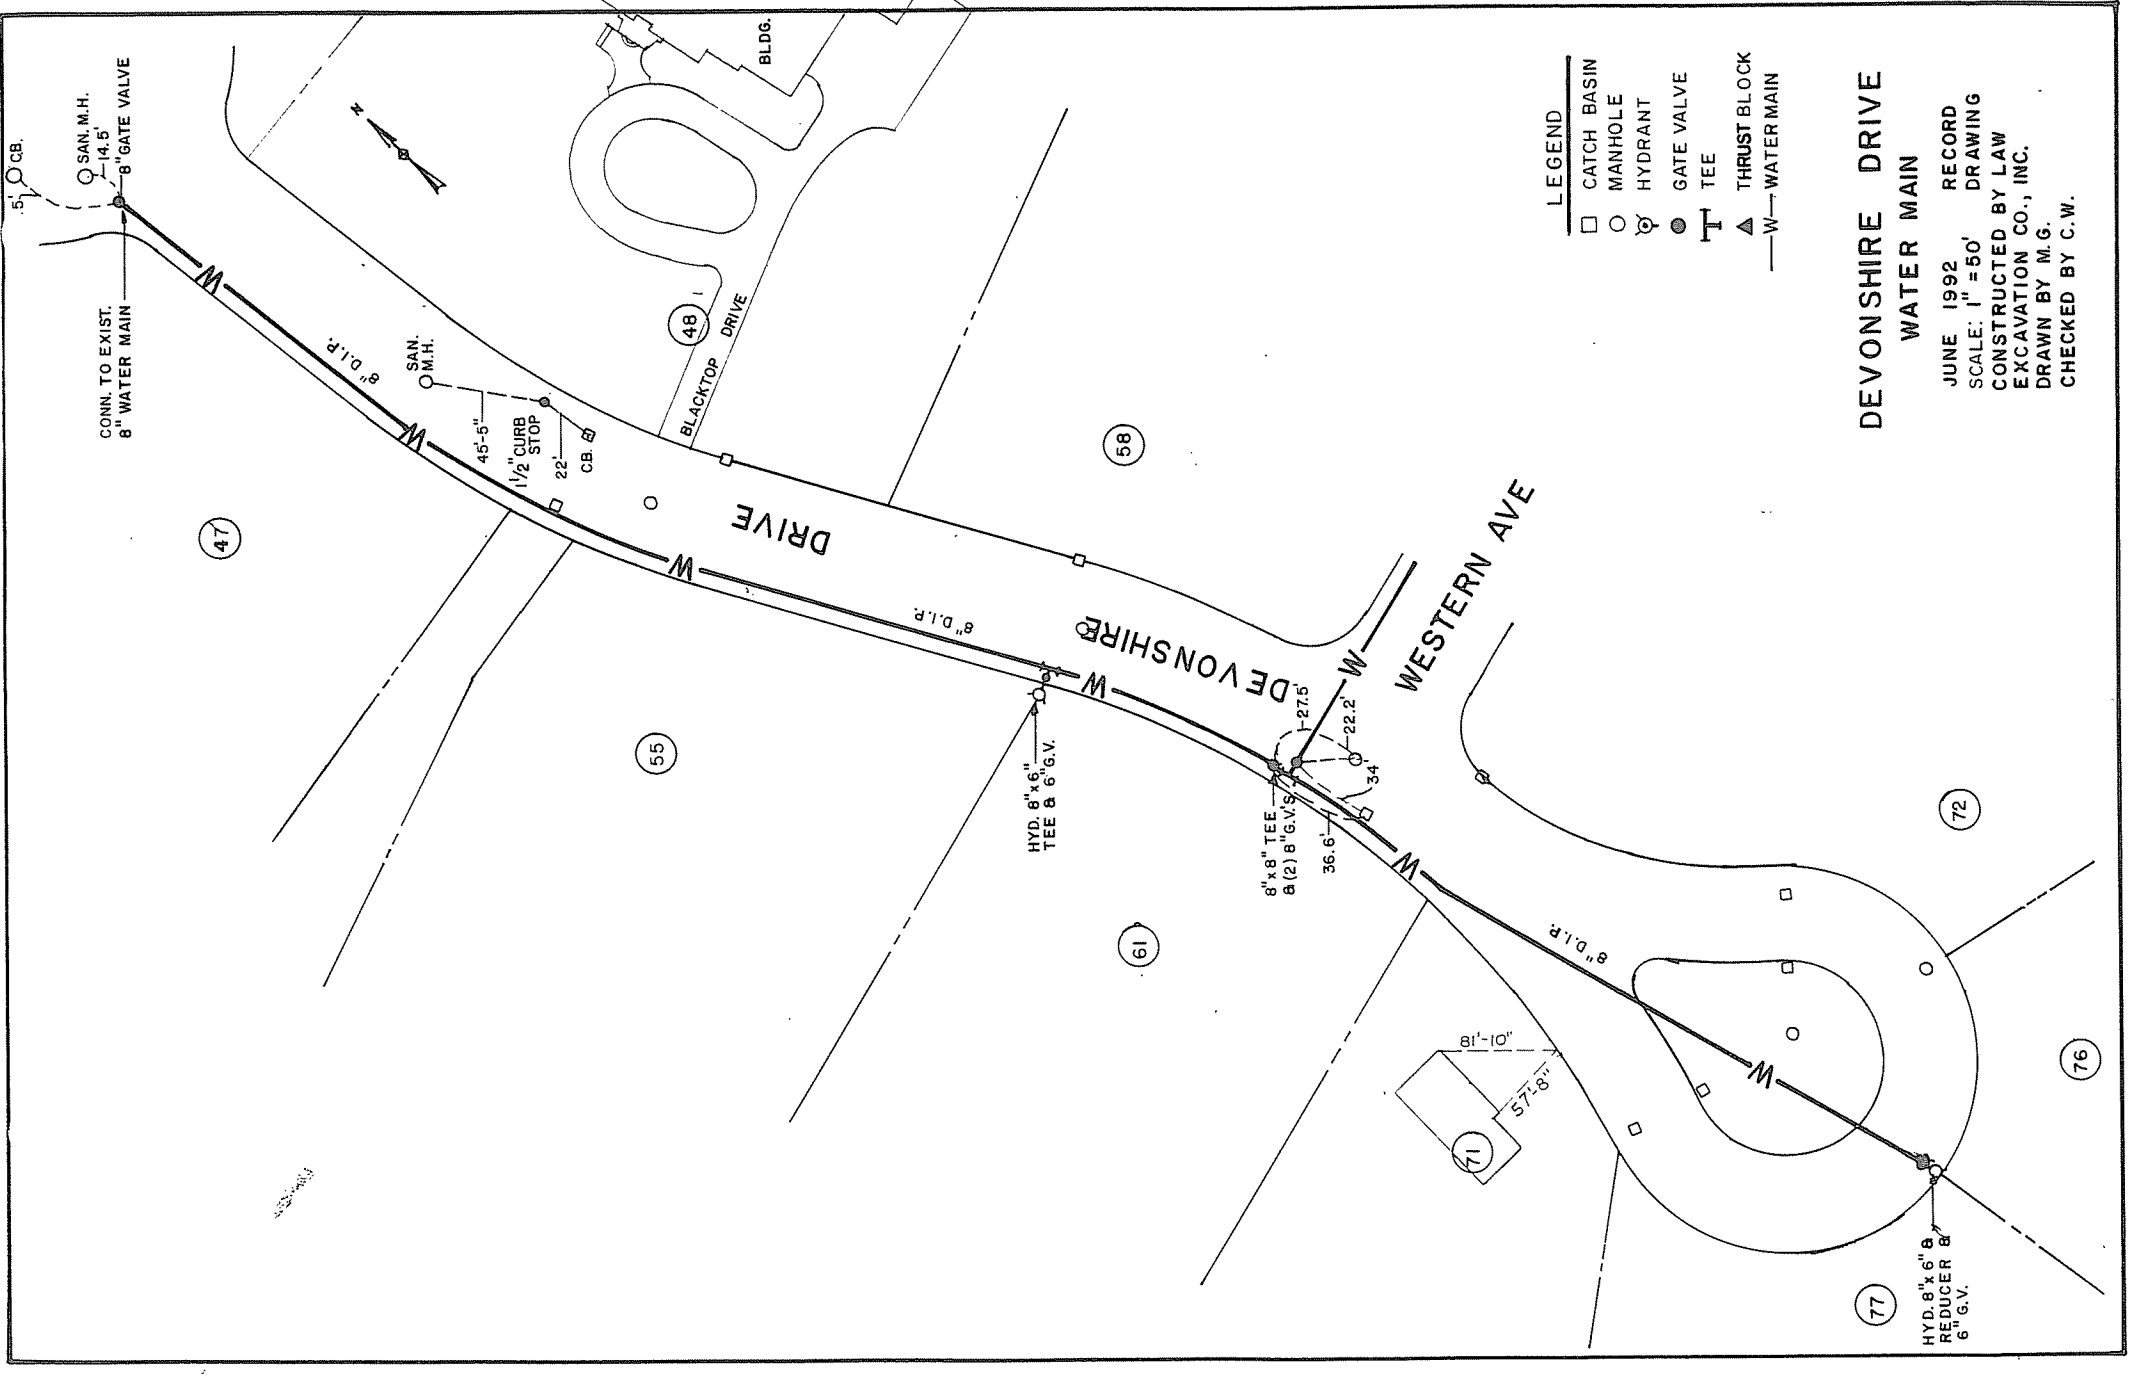

- LEGEND**
- CATCH BASIN
 - MANHOLE
 - ⊕ HYDRANT
 - GATE VALVE
 - T TEE
 - ▲ THRUST BLOCK
 - W — WATER MAIN

DEVONSHIRE DRIVE WATER MAIN

JUNE 1992 RECORD
 SCALE: 1" = 50' DRAWING
 CONSTRUCTED BY LAW
 EXCAVATION CO., INC.
 DRAWN BY M.G.
 CHECKED BY C.W.