


LEGEND

- MANHOLE
- STORMILET
- ⊗ VALVE
- △ THRUST BLOCK
- ⊥ TEE
- CURB BOX
- W— WATER MAIN
- SA SANITARY SEWER
- ST STORM SEWER

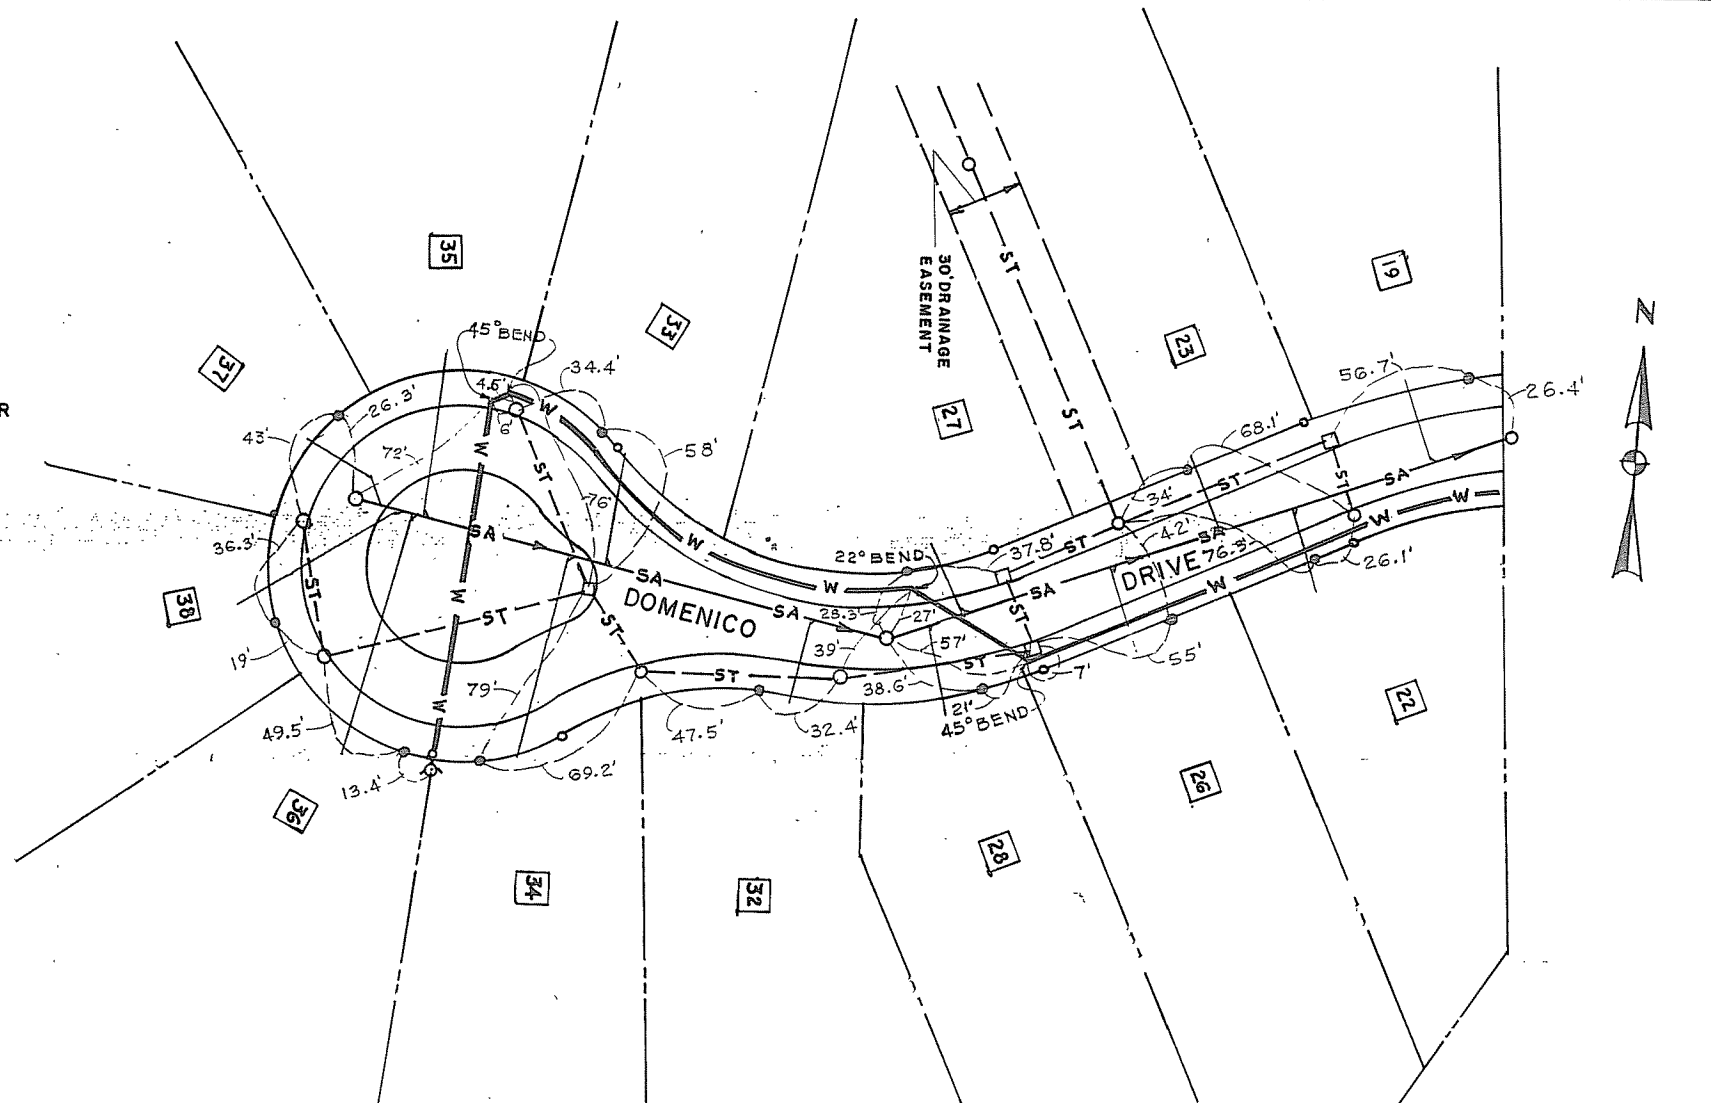

COUNTY ALBANY	DOMENICO DRIVE WATER MAIN ADAMS WOODS SECTION 2	STATE NEW YORK
DATE SEPT. 1999		SCALE 1" = 50'
REVISION	 TOWN OF BETHLEHEM ENGINEERING DIVISION 445 Delaware Ave. Delmar, New York 12054	DRAWING NO.