


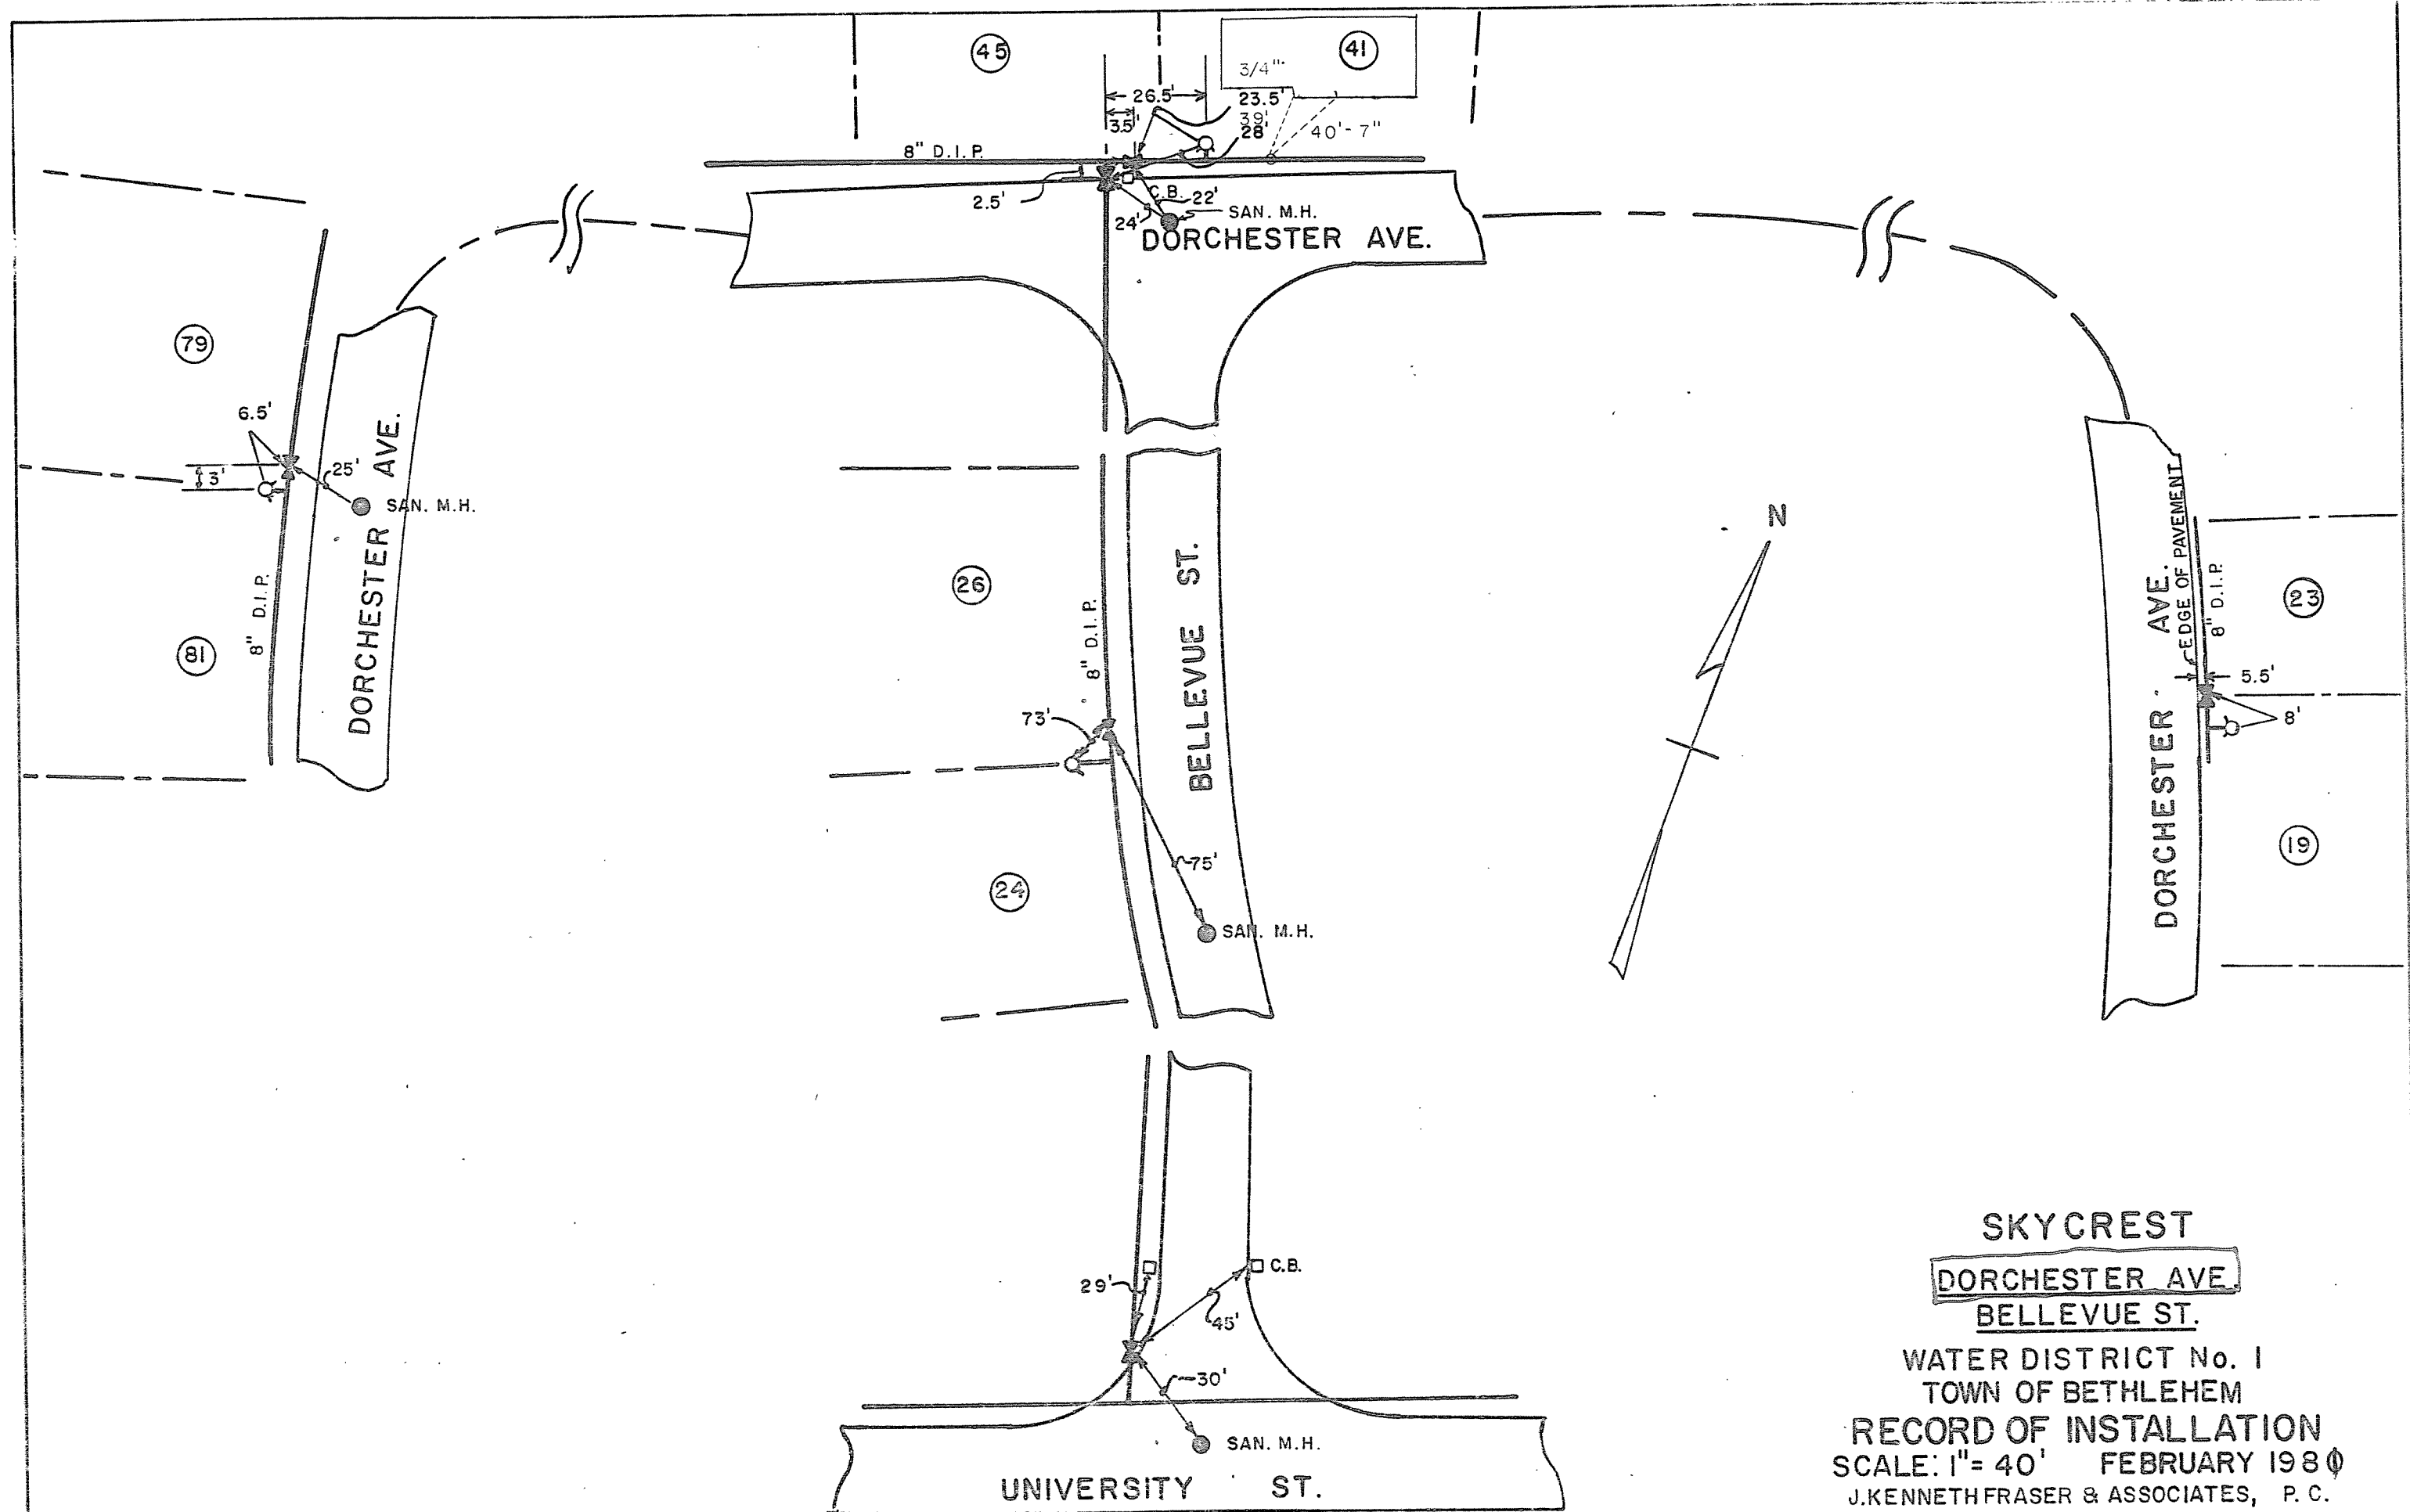

DWN. BY H.P.J.
CHK. BY W.T.B.