


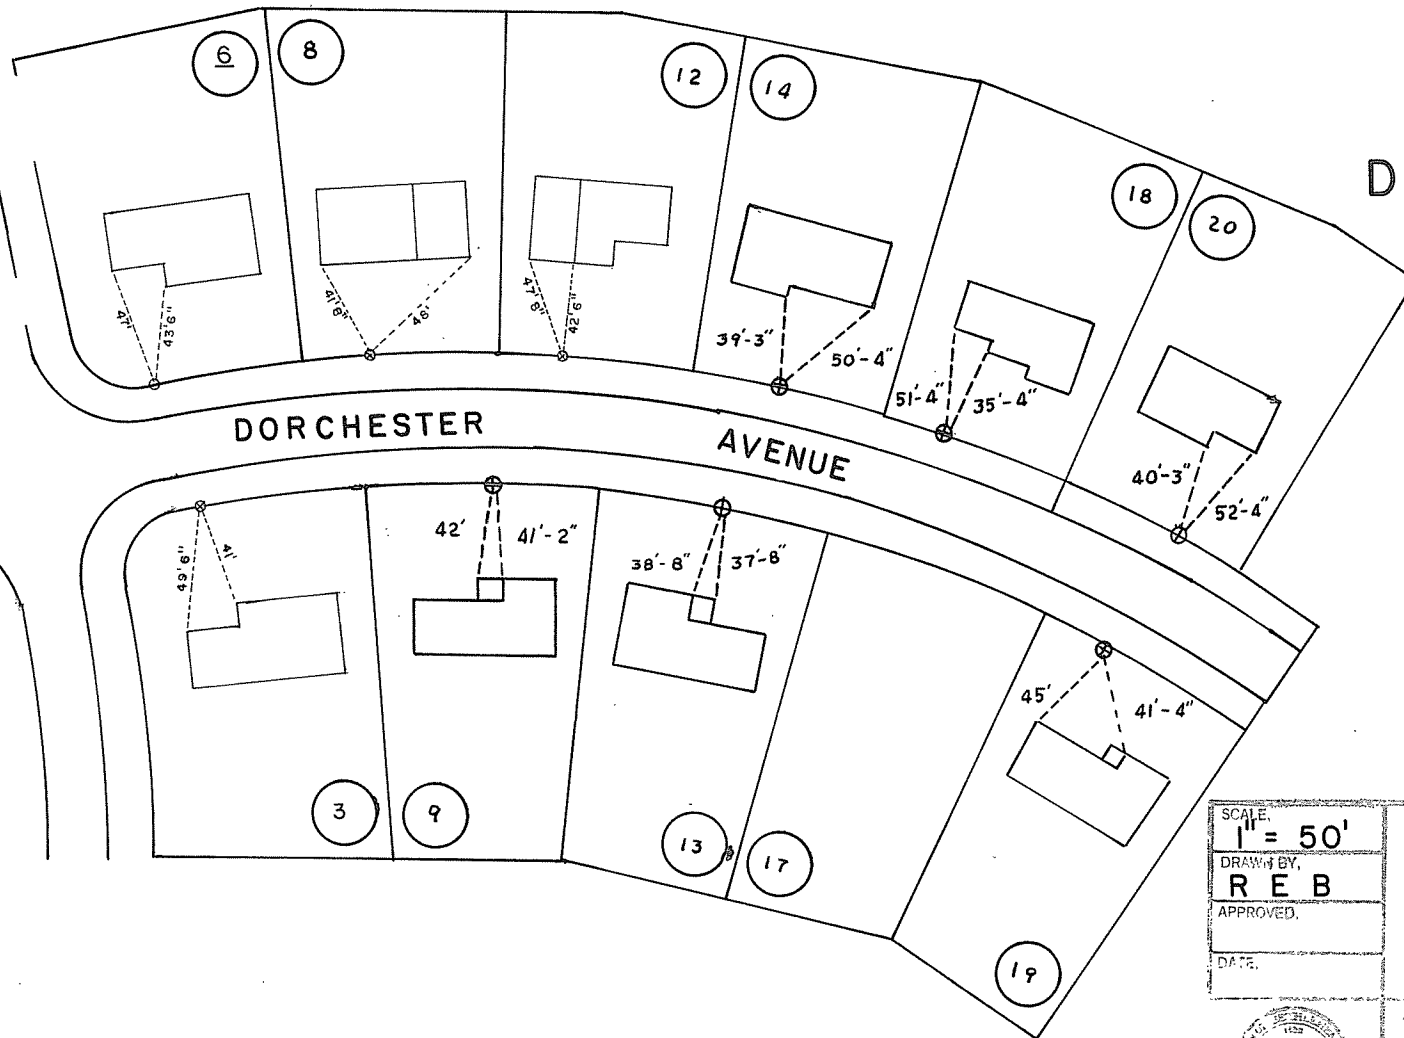

DORCHESTER
AVENUE

SCALE,
1" = 50'
DRAWN BY,
R E B
APPROVED,
DATE,



TOWN OF BETHEL
ENGINEERING DEPARTMENT
345 DELAWARE AVE. DELMAR, NEW YORK 12054

DRAWN BY NUMBER,