


DOUGLAS ROAD
WATER DISTRICT NO. 1
TOWN OF BETHLEHEM


RECORD OF INSTALLATION
TOWN OF BETHLEHEM ENGINEERING
DEPARTMENT

SCALE: 1" = 50' DECEMBER, 1982
DRAWN BY PDH



N

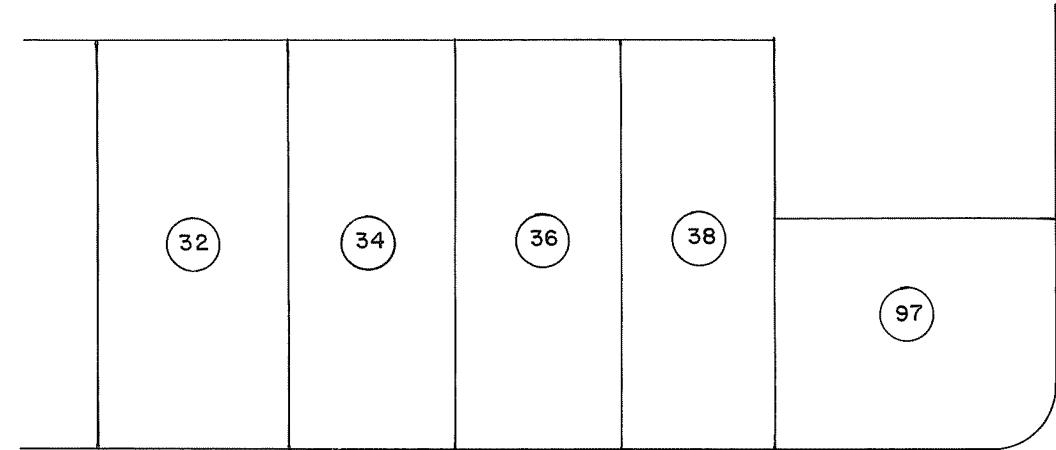

DOUGLAS

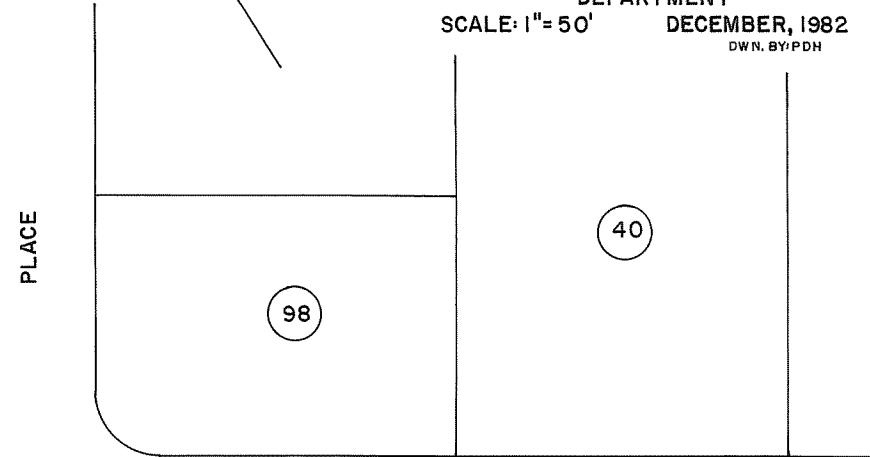

ROAD

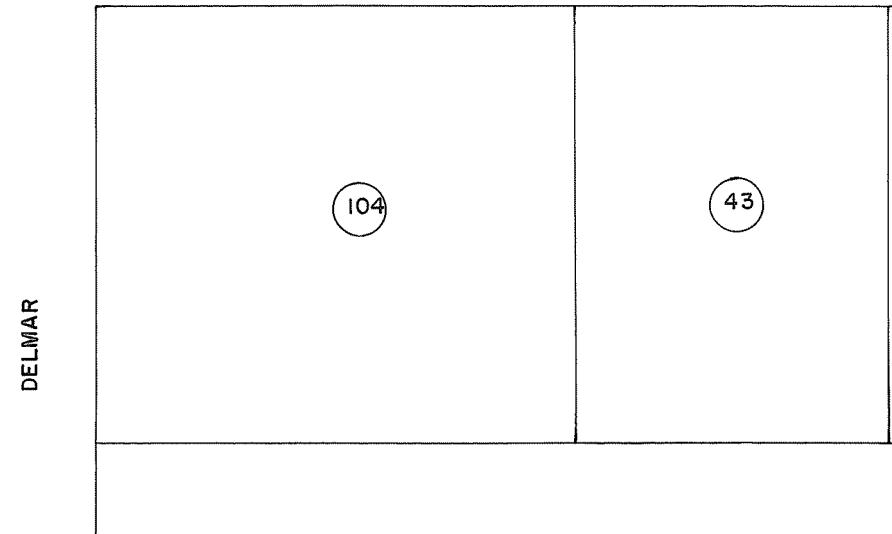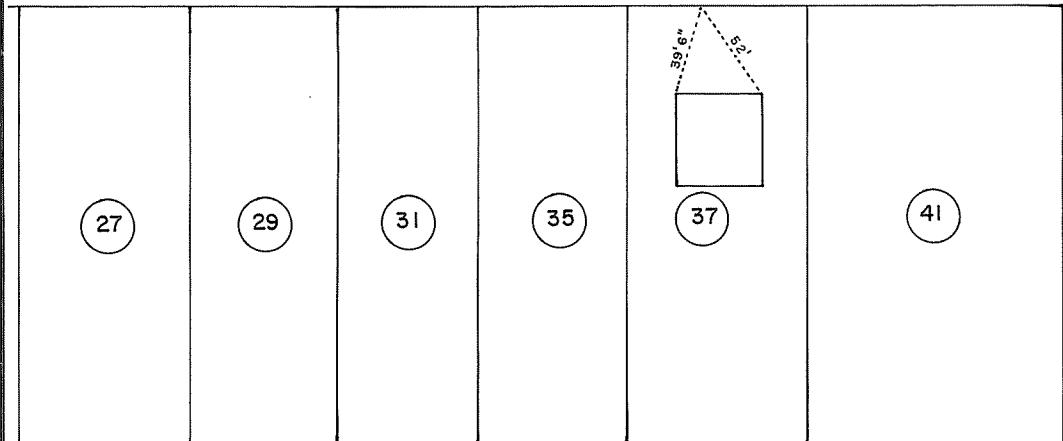

DELMAR