



ELM AVENUE

DOVER DRIVE


50

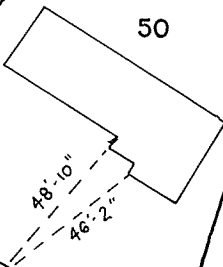


54

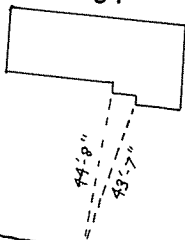


58

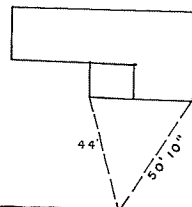

62

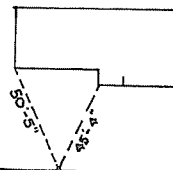


64

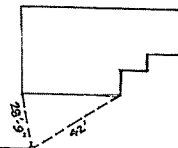


51

53


55

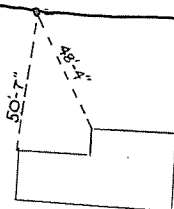

59

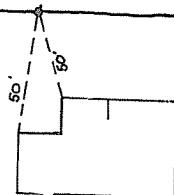

63

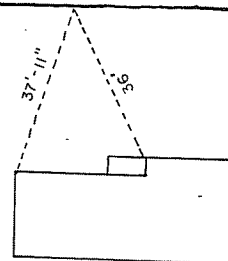

65

