


# LEGEND

- CATCH BASIN
- MANHOLE
- ⊙ HYDRANT
- GATE VALVE
- ⊥ TEE
- ▲ THRUST BLOCK
- W— WATER MAIN

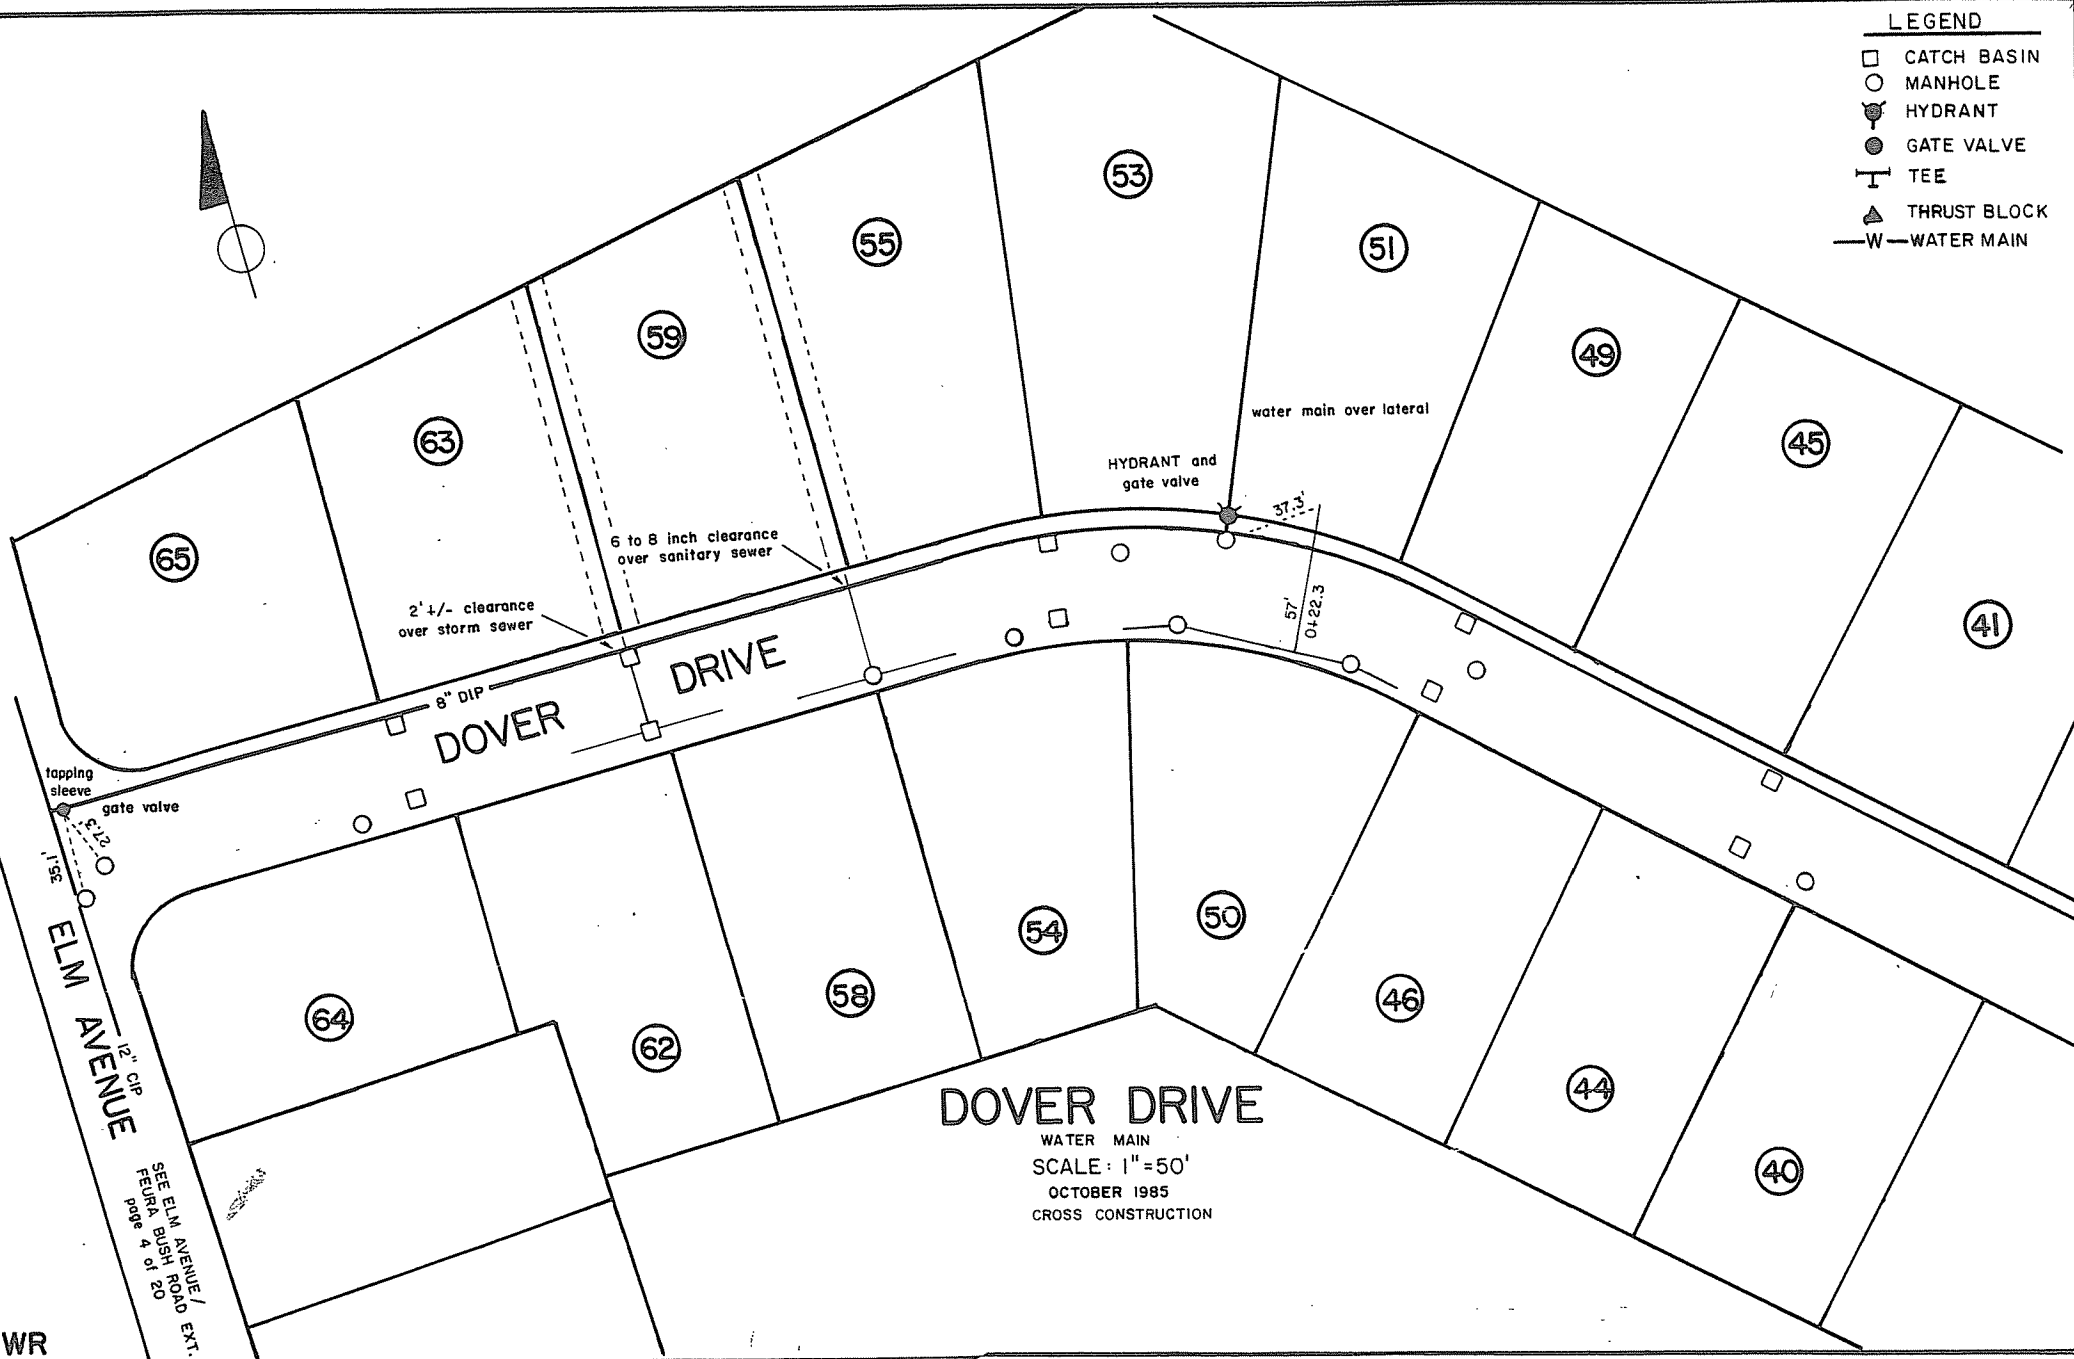

DOVER DRIVE

WATER MAIN

SCALE: 1"=50'

OCTOBER 1985

CROSS CONSTRUCTION

TWR