


LEGEND

- CATCH BASIN
- MANHOLE
- ⊙ HYDRANT
- ⊗ GATE VALVE
- ⊥ TEE
- ▲ THRUST BLOCK
- W — WATER MAIN
- - - ST — STORM SEWER
- - - SA — SANITARY SEWER
- CURB BOX

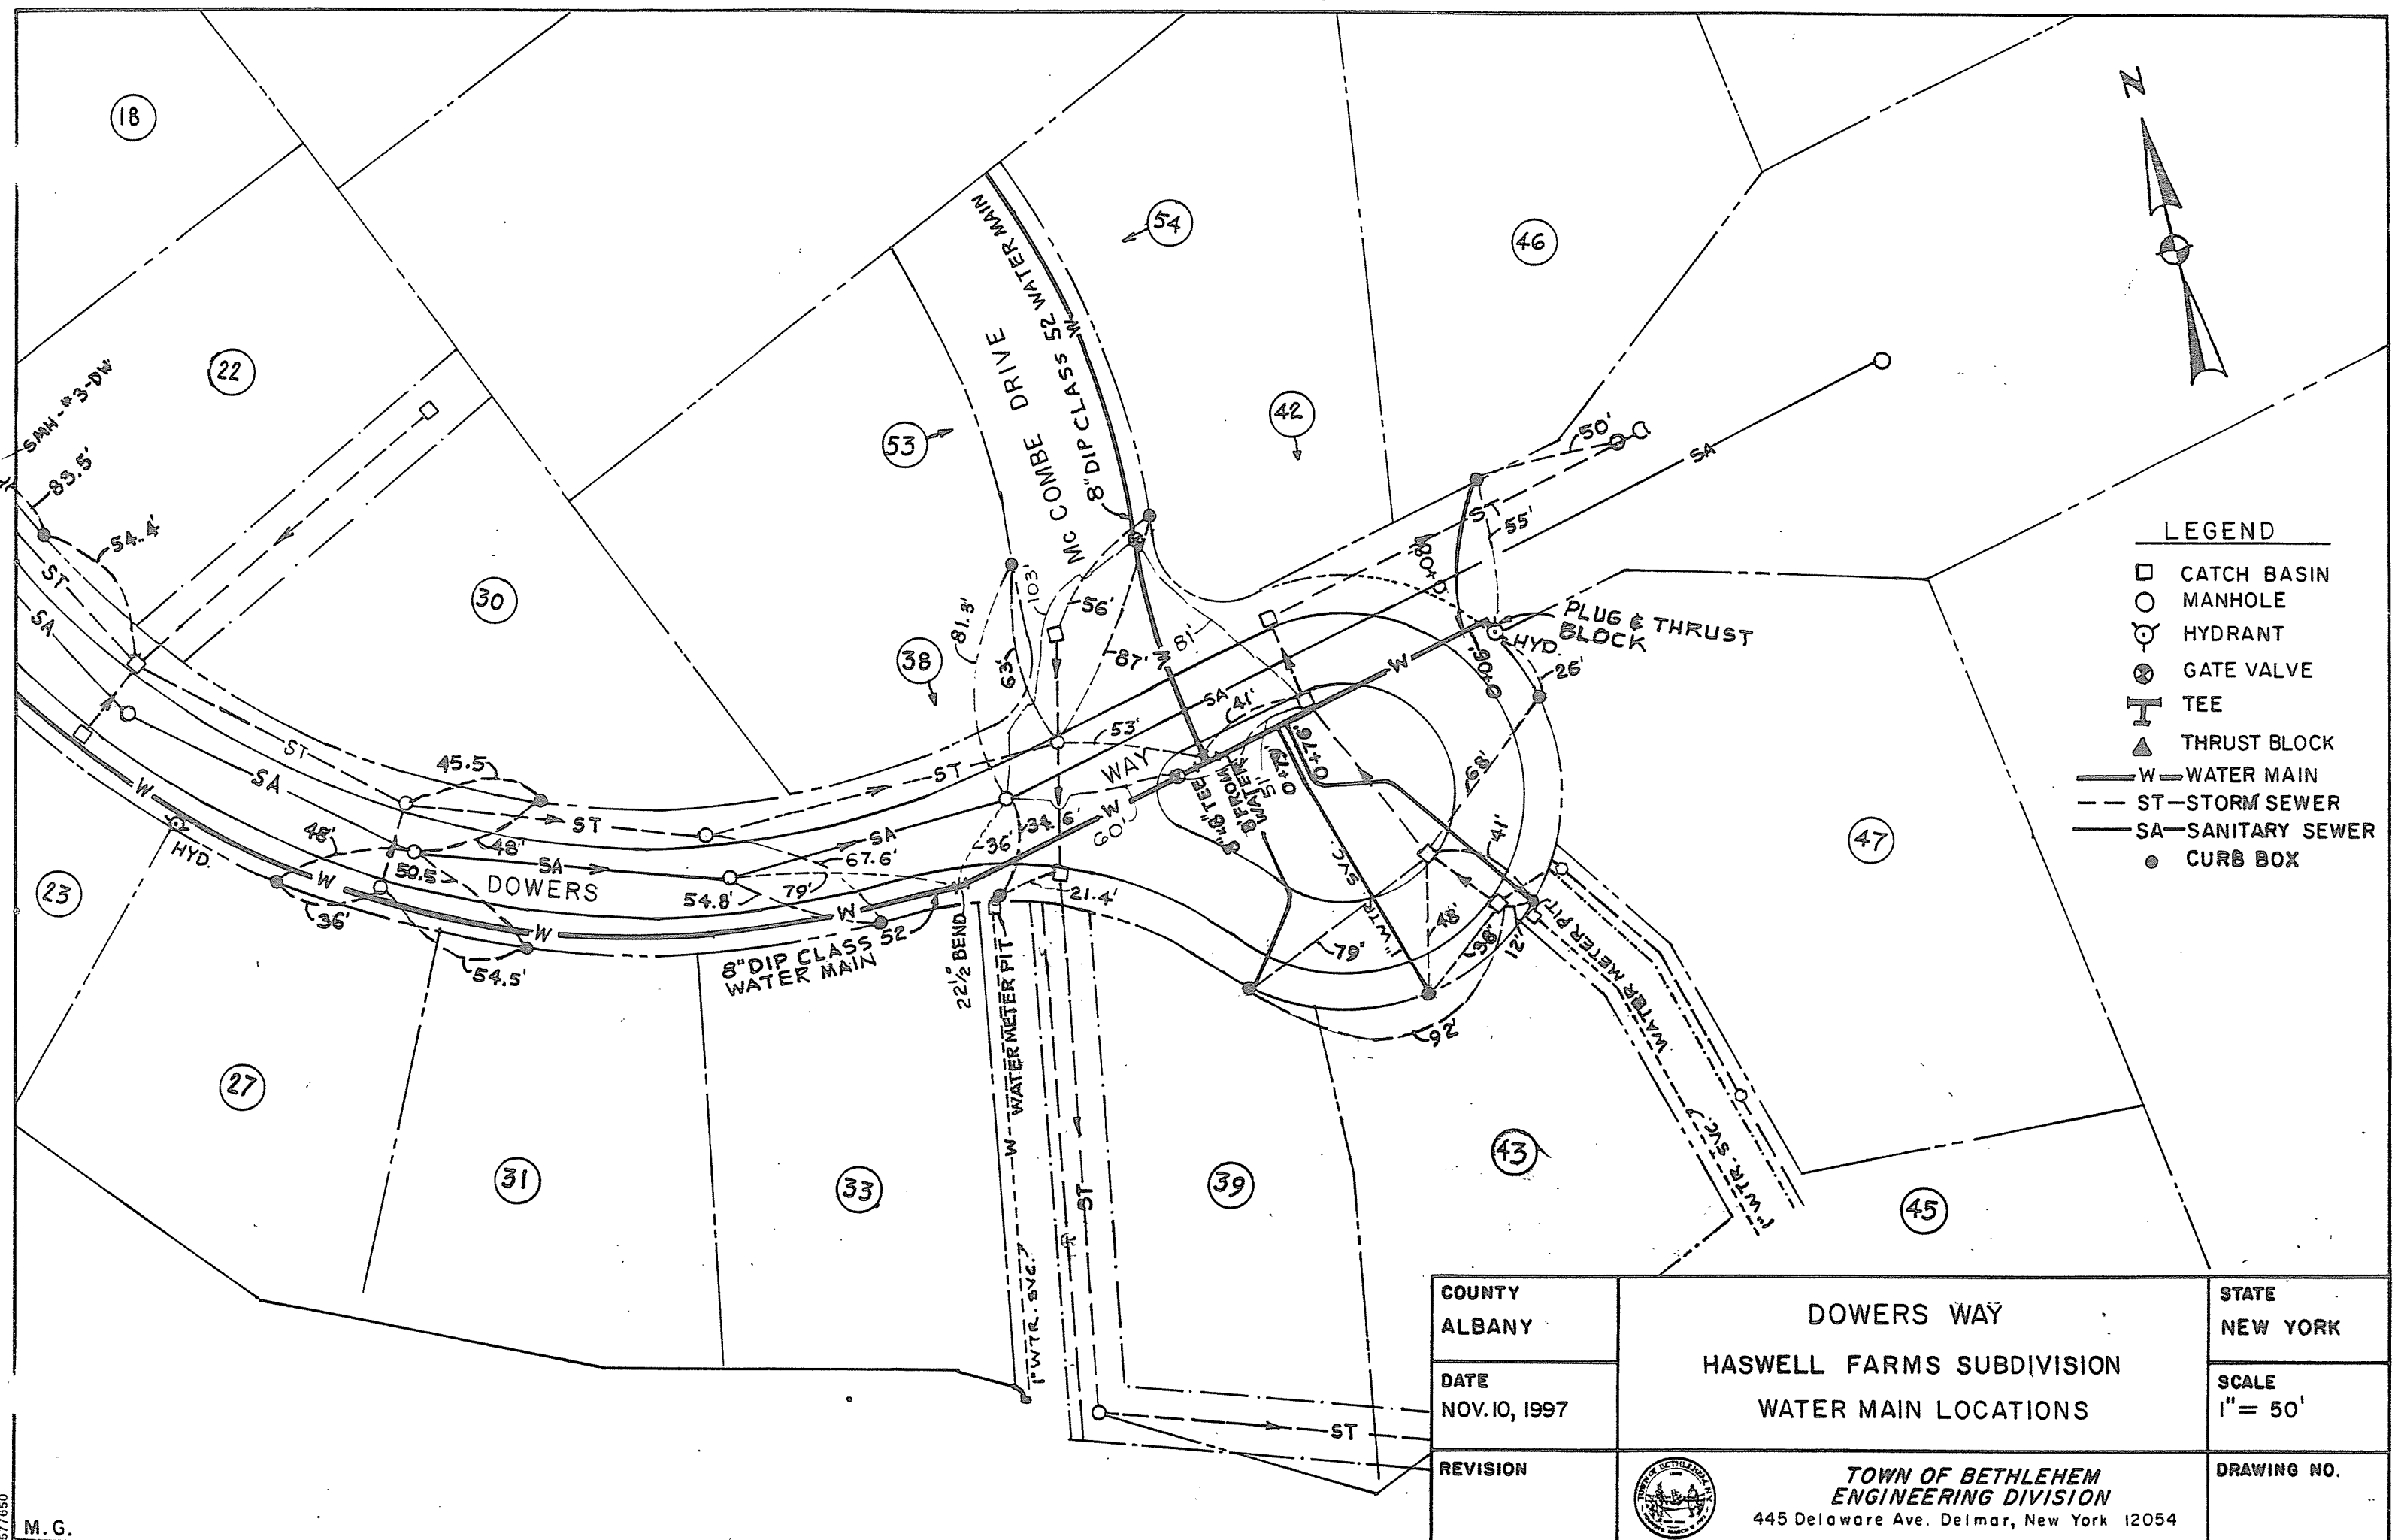

COUNTY ALBANY	DOWERS WAY HASWELL FARMS SUBDIVISION WATER MAIN LOCATIONS	STATE NEW YORK
DATE NOV. 10, 1997		SCALE 1" = 50'
REVISION	 TOWN OF BETHLEHEM ENGINEERING DIVISION 445 Delaware Ave. Delmar, New York 12054	DRAWING NO.