



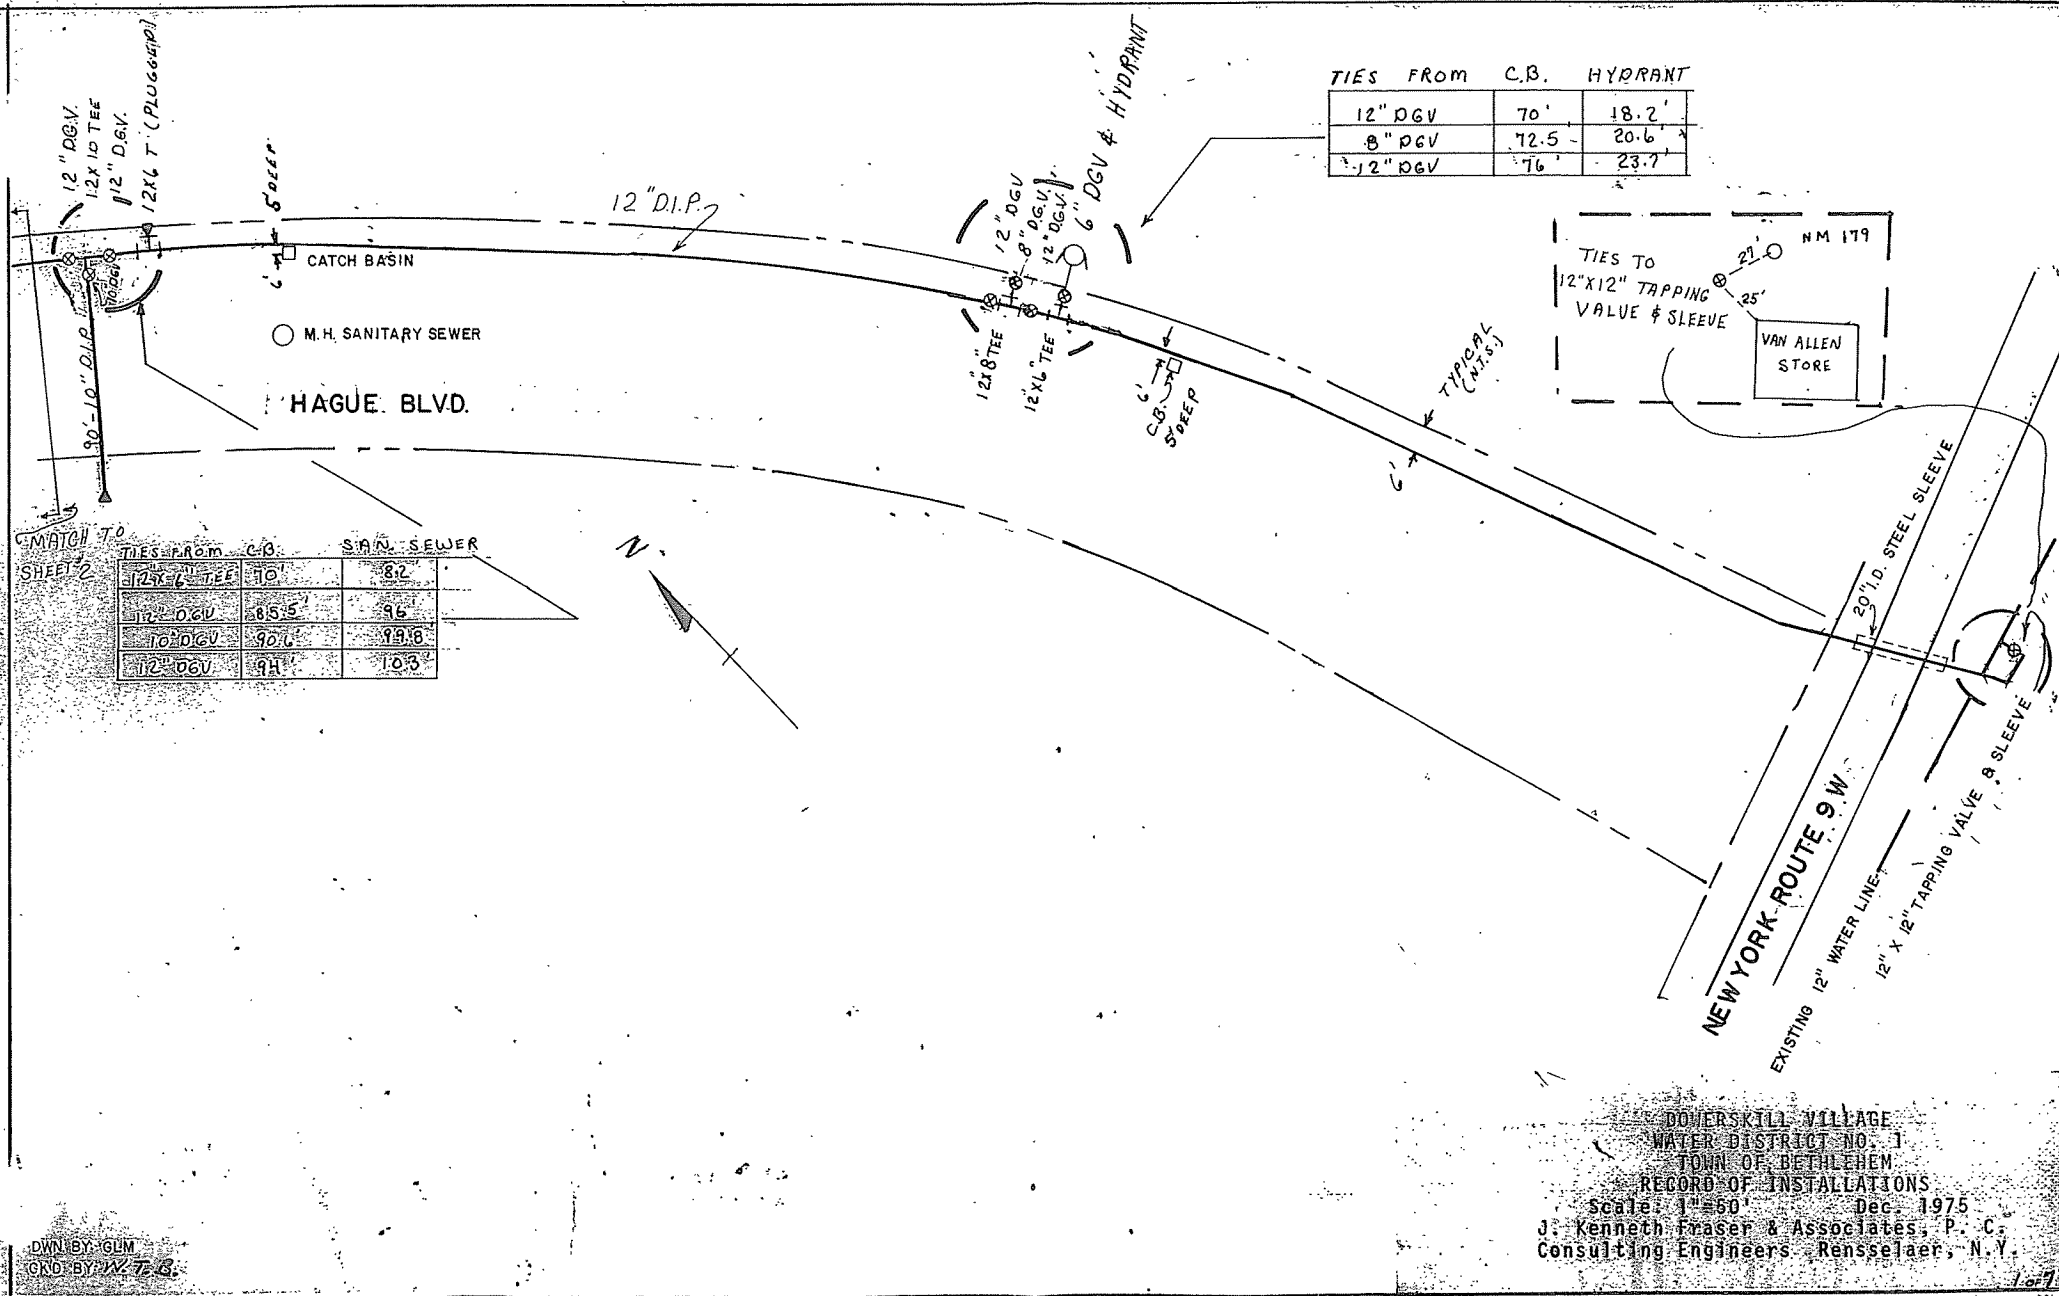

TIES FROM C.B. HYDRANT

12" DGV	70'	18.2'
8" DGV	12.5'	20.6'
12" DGV	76'	23.7'

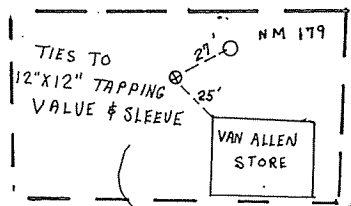

MATCH TO SHEET 2

TIES FROM C.B. SAN. SEWER

12\"/>

DOHERSKILL VILLAGE
 WATER DISTRICT NO. 1
 TOWN OF BETHLEHEM
 RECORD OF INSTALLATIONS
 Scale: 1"=50' Dec. 1975
 J. Kenneth Fraser & Associates, P. C.
 Consulting Engineers, Rensselaer, N.Y.