


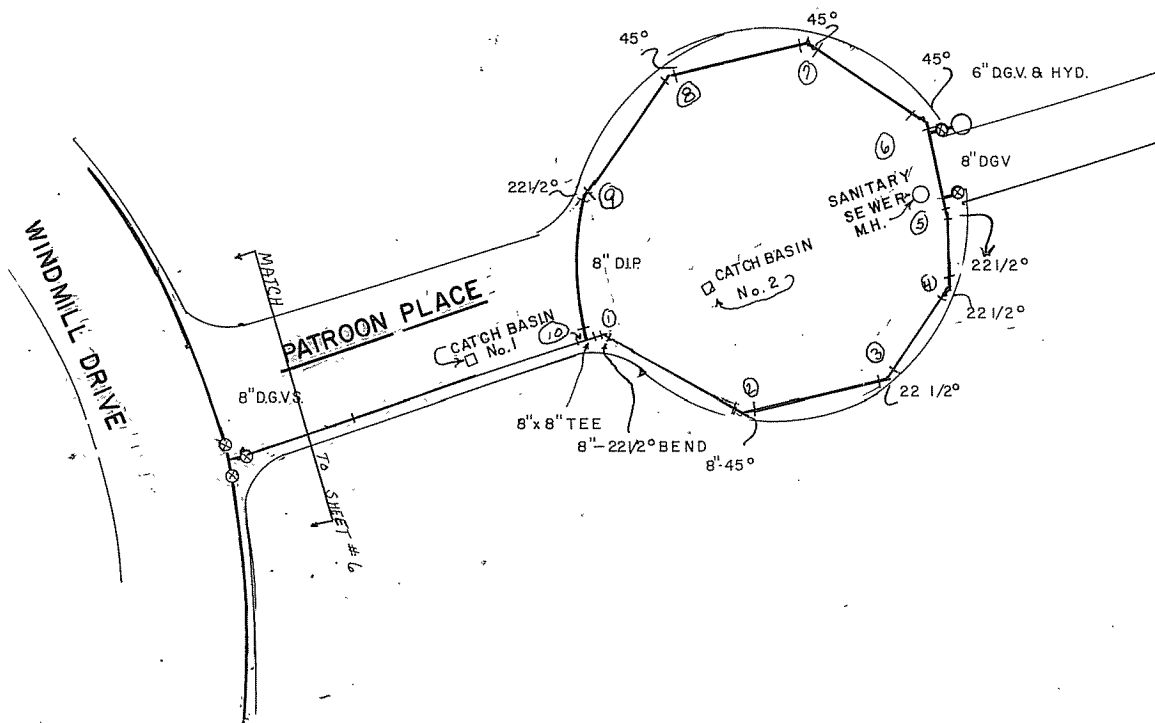

FITTING #	C.B. #1	C.B. #2	SAW M.H.
1	59.5'	38.7'	
2		50.9'	105'
3		77.0'	62'
4		88'	41'
5		96'	18.6'
6		101'	25'
7		107.5'	38'
8		98'	82'
9		79.2'	121'
10	56.5'	40.7'	
8" D.G.V.		101.4'	13.9'

DOWERSKILL VILLAGE
 WATER DISTRICT NO. 1
 TOWN OF BETHLEHEM
 RECORD OF INSTALLATIONS
 Scale: 1"=50' Dec. 1975
 J. Kenneth Fraser & Associates, P. C.
 Consulting Engineers Rensselaer, N.Y.