


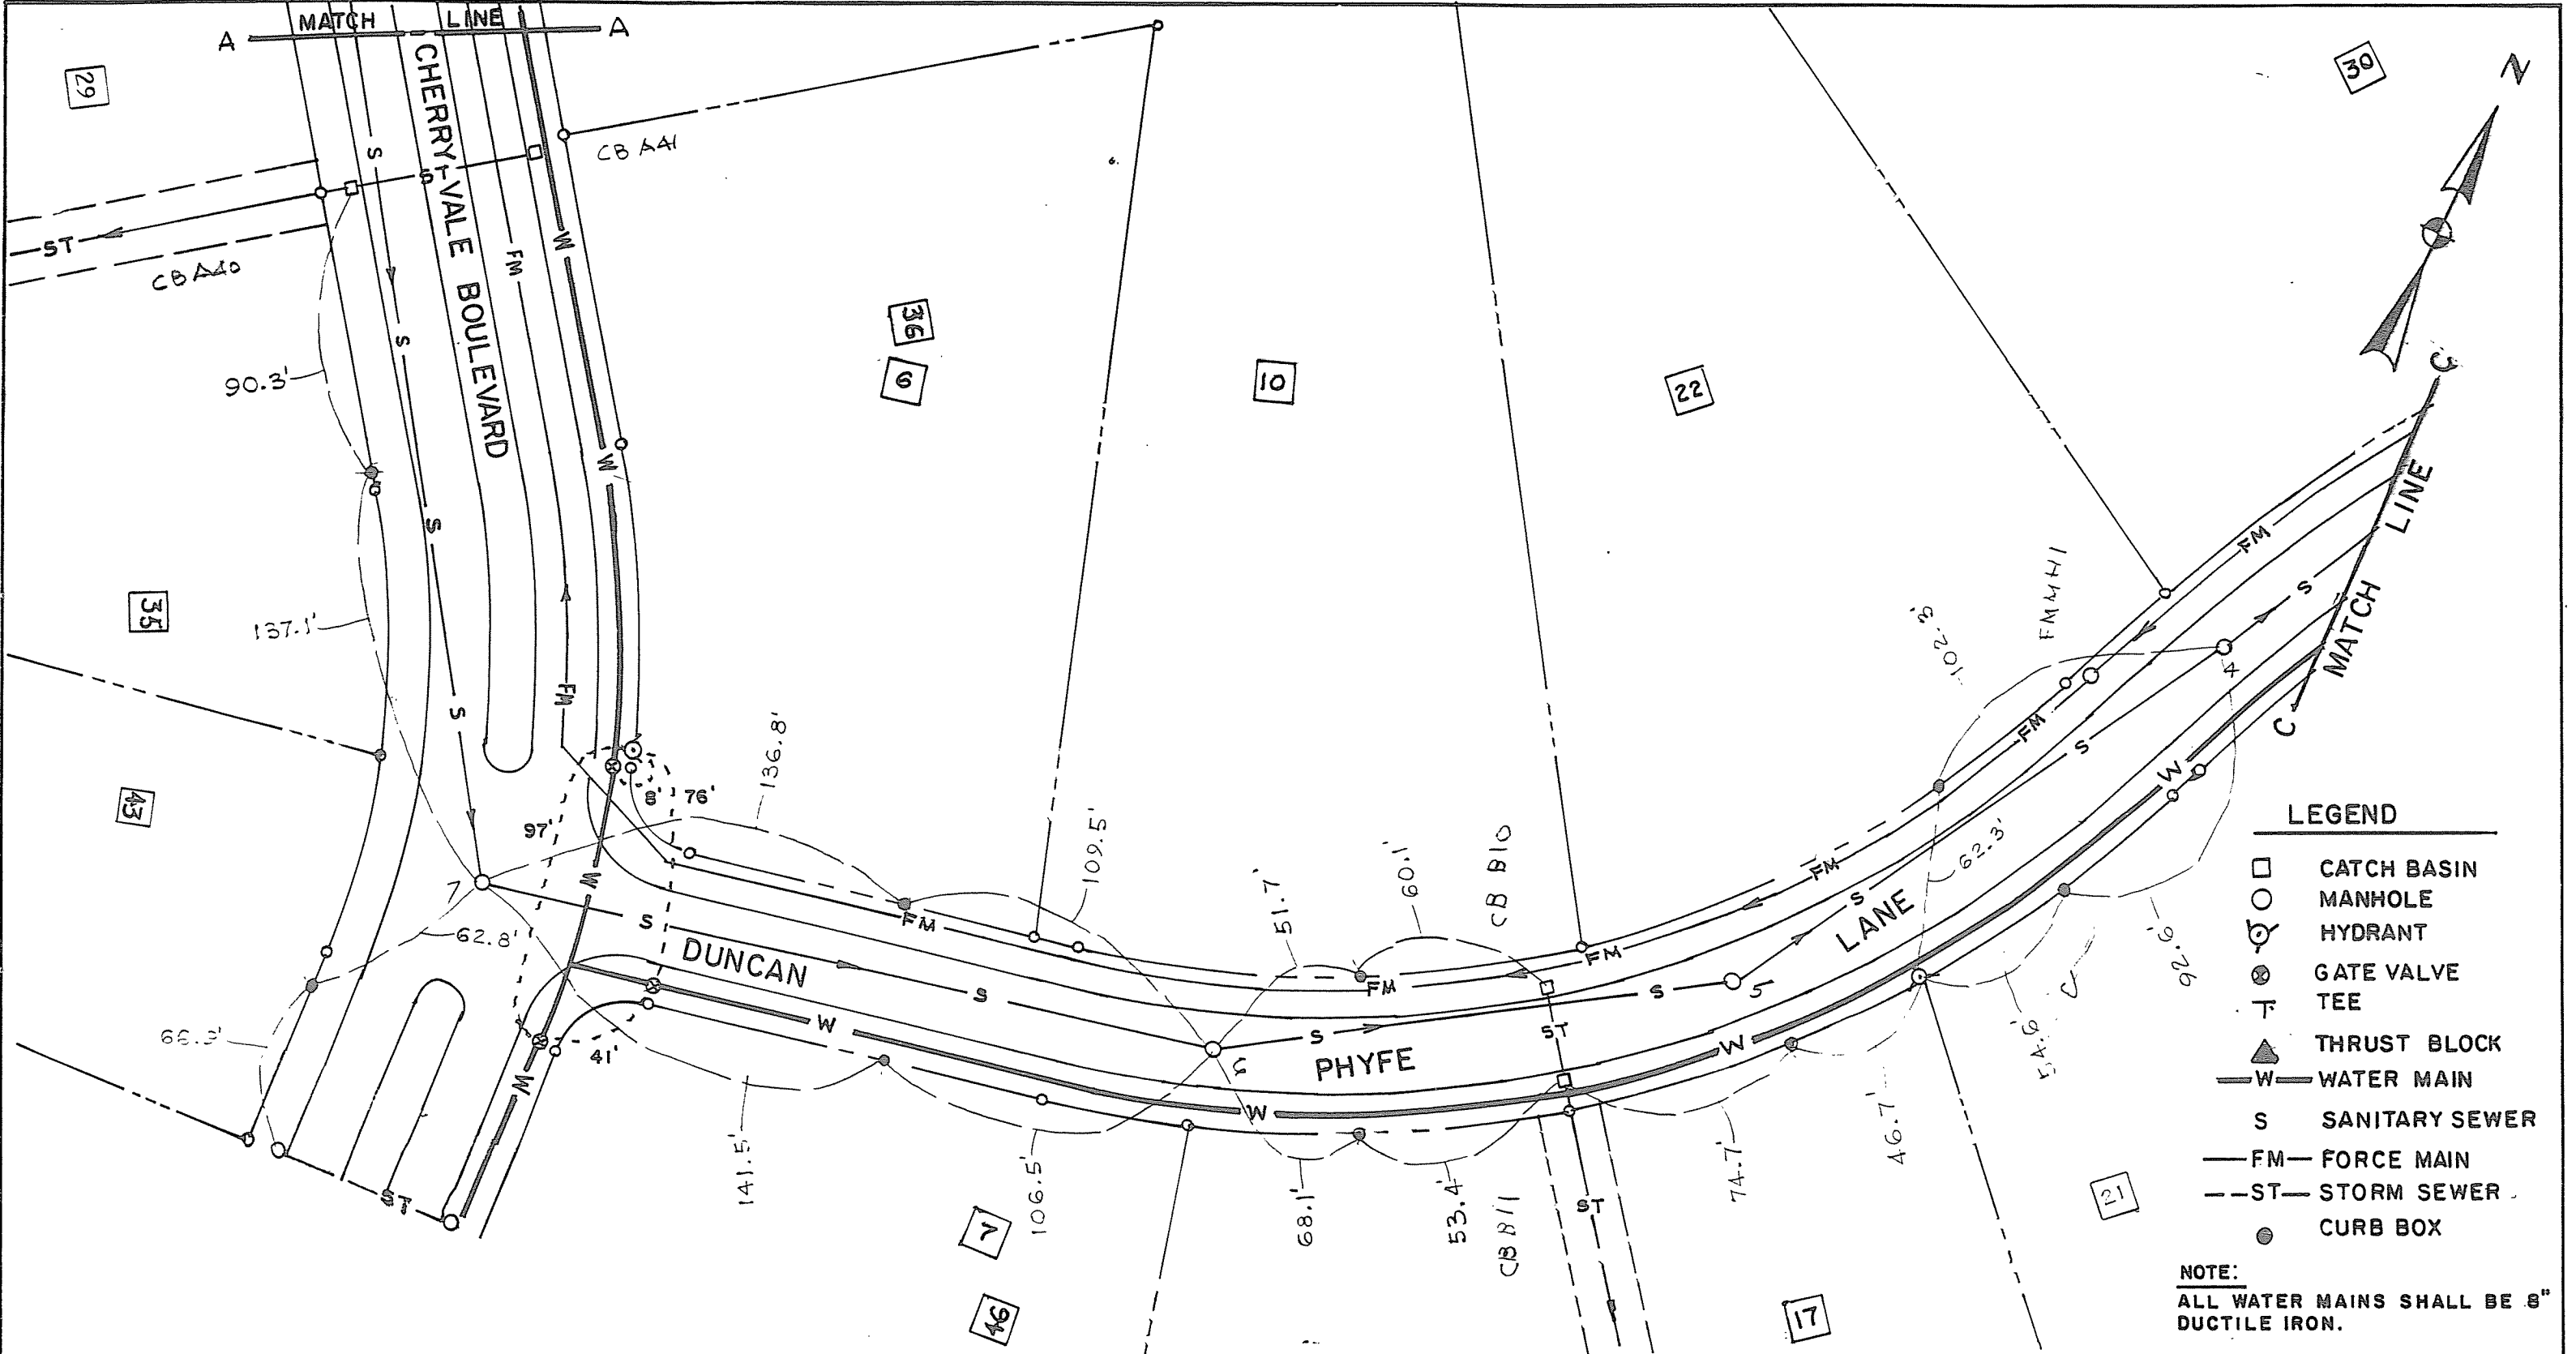

LEGEND

- CATCH BASIN
- MANHOLE
- ⊙ HYDRANT
- ⊗ GATE VALVE
- ⊥ TEE
- ▲ THRUST BLOCK
- W— WATER MAIN
- S SANITARY SEWER
- FM— FORCE MAIN
- ST--- STORM SEWER
- CURB BOX

NOTE:
ALL WATER MAINS SHALL BE 8" DUCTILE IRON.

COUNTY ALBANY	DUNCAN PHYFE LANE WATER MAIN	STATE NEW YORK
DATE JUNE 2, 1999		SCALE 1" = 50'
REVISION	 TOWN OF BETHLEHEM ENGINEERING DIVISION 445 Delaware Ave. Delmar, New York 12054	DRAWING NO.