




ELEVATION INFO:

- 1.) T/12" MAIN AT 12 x 8 TAP --- 182.05'
- 2.) T/24" CASING NORTH SIDE-- 182.31'
- 3.) P.V.M.T. FEURA BUSH ROAD-- 188.51'
- 4.) T/8" MAIN AT CASING NORTH SIDE. --- 181.30'

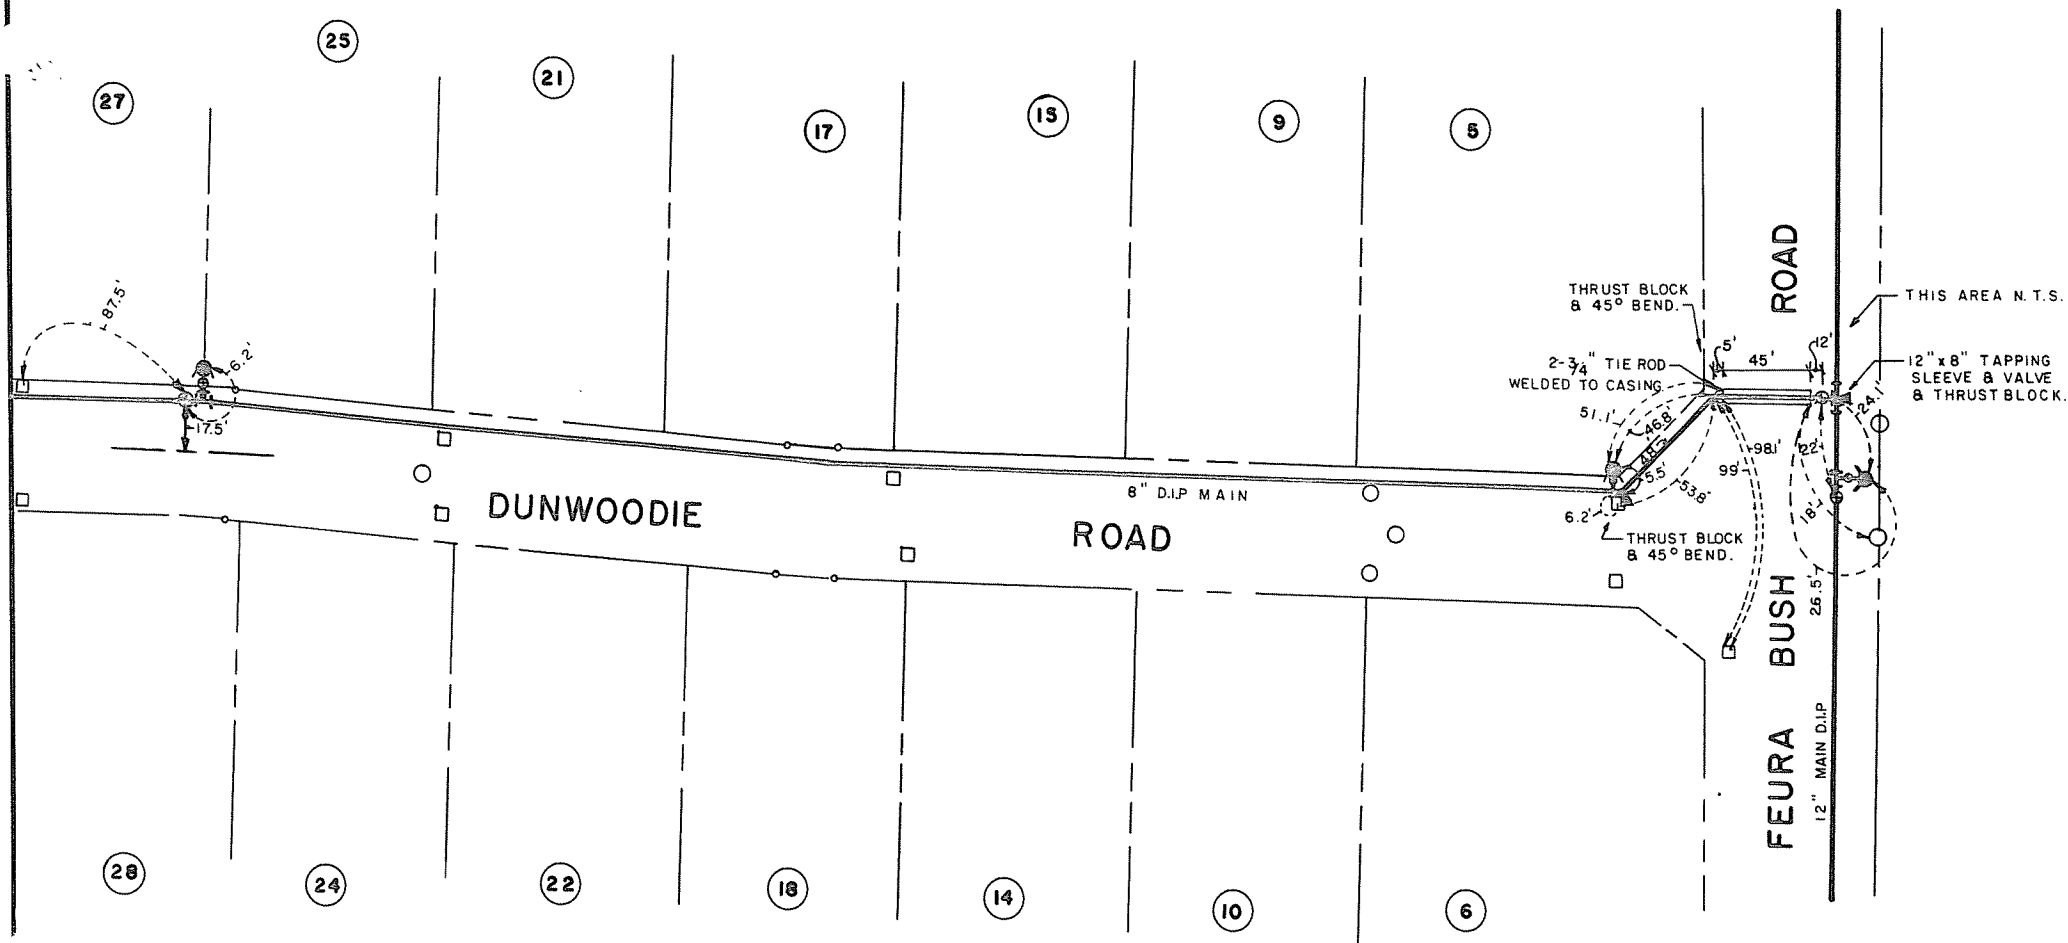

DUNWOODIE ROAD

WATER MAIN

SCALE: 1" = 50'

AUG. 1991

CONSTRUCTED BY MICHELI CONSTRUCTION
INSPECTED BY T.O.B.