
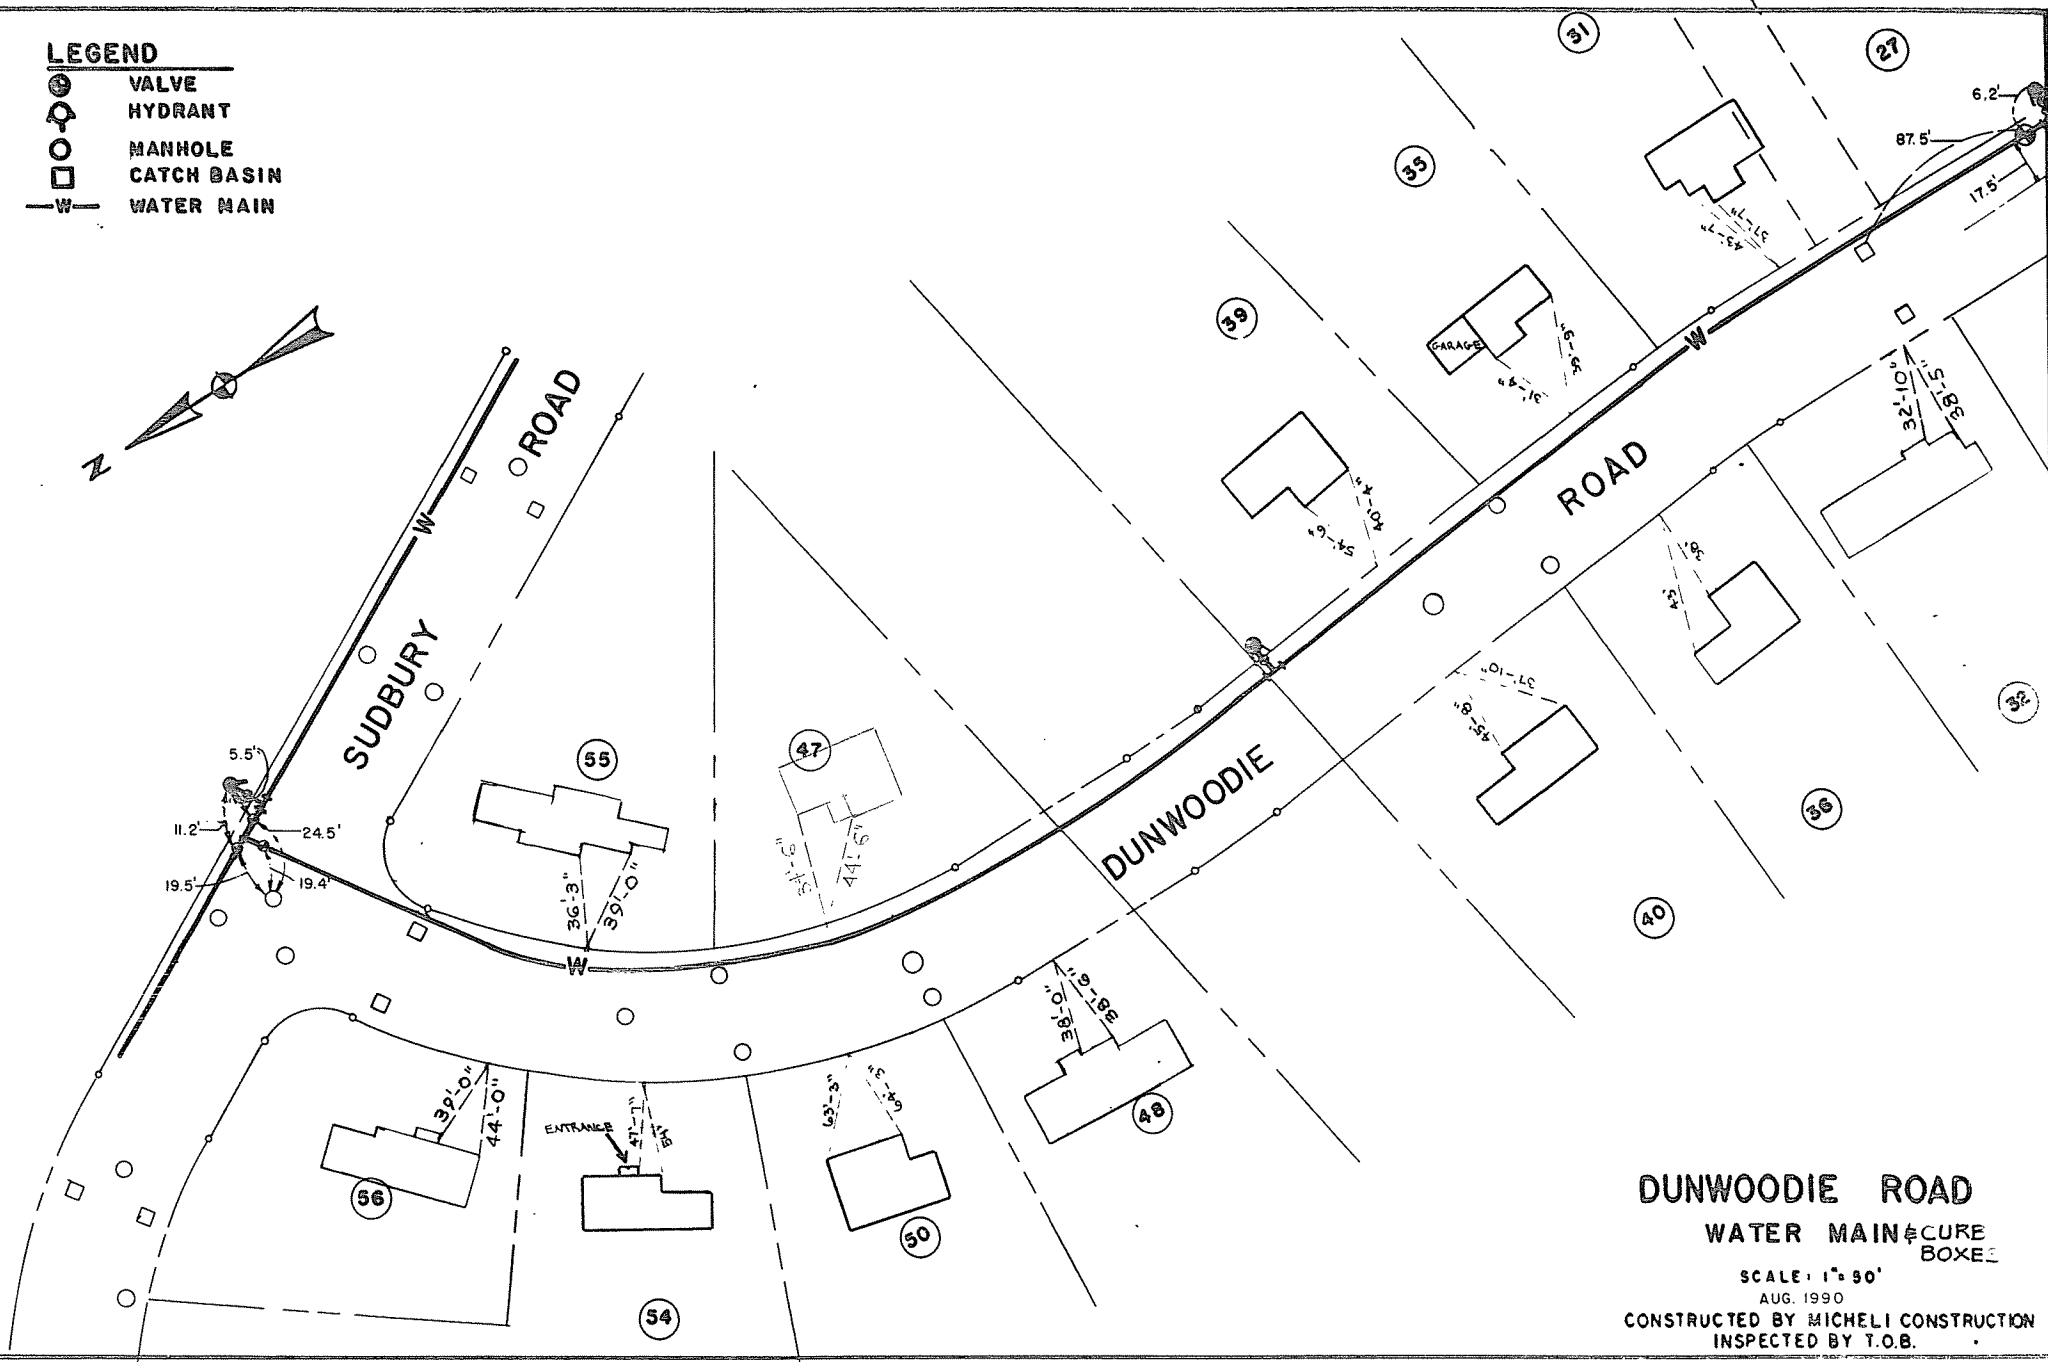


# LEGEND

- VALVE
- HYDRANT
- MANHOLE
- CATCH BASIN
- W— WATER MAIN

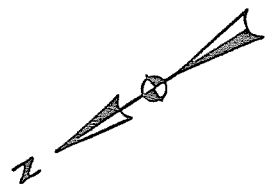

DUNWOODIE ROAD

WATER MAIN & CURE BOXES

SCALE: 1" = 50'

AUG. 1990

CONSTRUCTED BY MICHELI CONSTRUCTION  
INSPECTED BY T.O.B.