


LANDS OF THE DELAWARE AND HUDSON RAILWAY COMPANY

LANDS OF THE CITY OF ALBANY

LEGEND

- CATCH BASIN
- MANHOLE
- ⊕ HYDRANT
- ⊗ GATE VALVE
- T TEE
- ▲ THRUST BLOCK
- W— WATER MAIN
- SA— SANITARY SEWER
- ST--- STORM SEWER

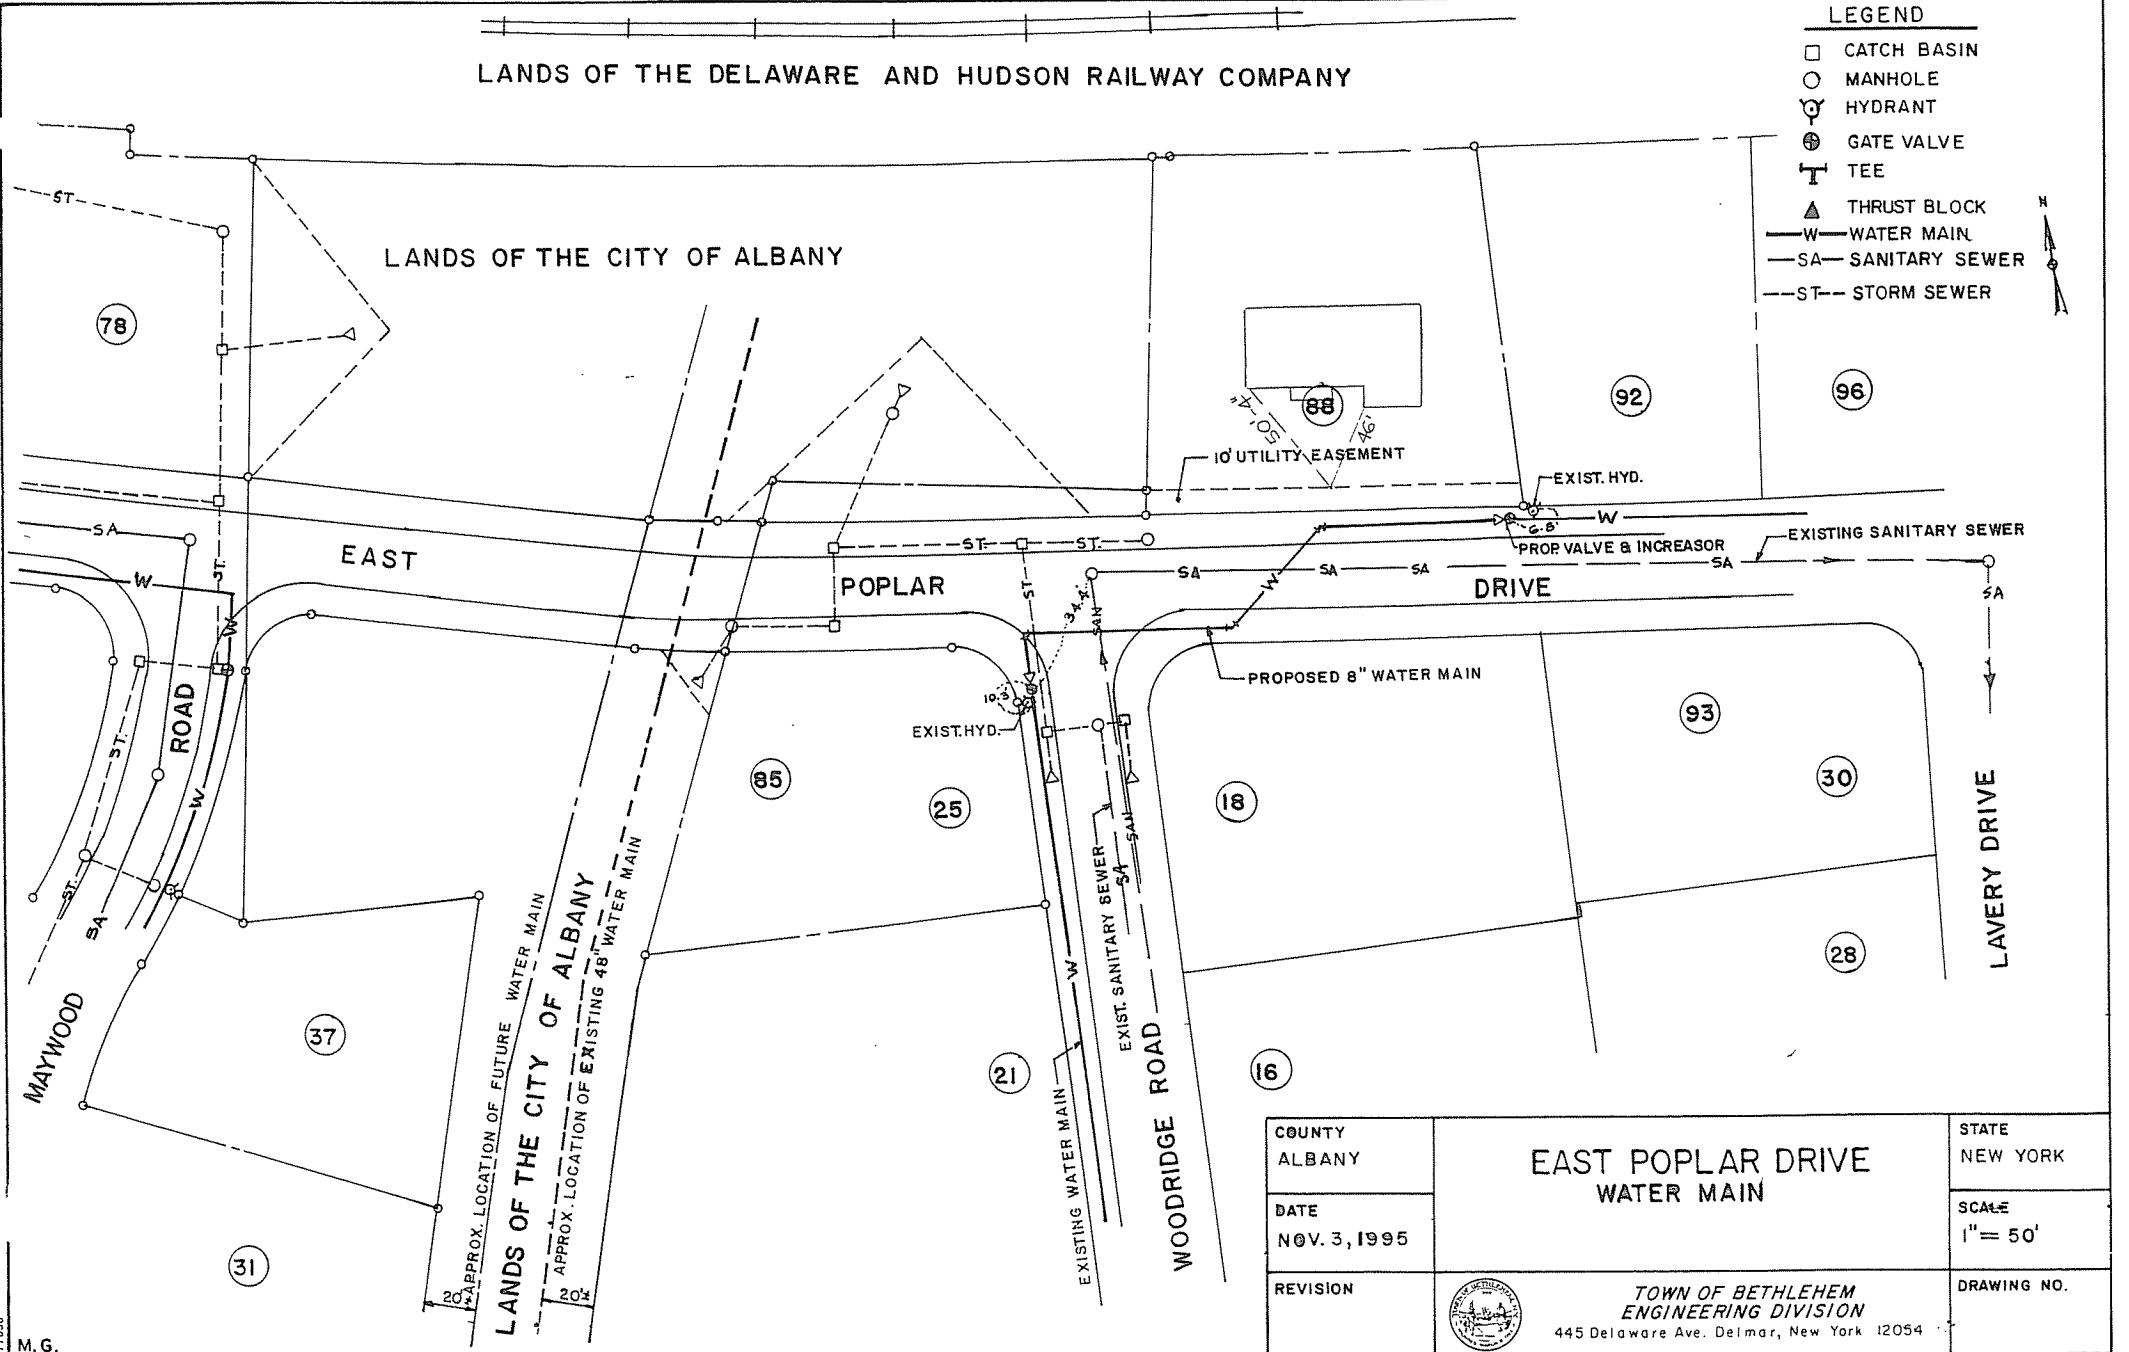

COUNTY ALBANY	EAST POPLAR DRIVE WATER MAIN	STATE NEW YORK
DATE NOV. 3, 1995		SCALE 1" = 50'
REVISION	 TOWN OF BETHLEHEM ENGINEERING DIVISION 445 Delaware Ave. Delmar, New York 12054	DRAWING NO.

EAST POPLAR DRIVE Colonial Woods