


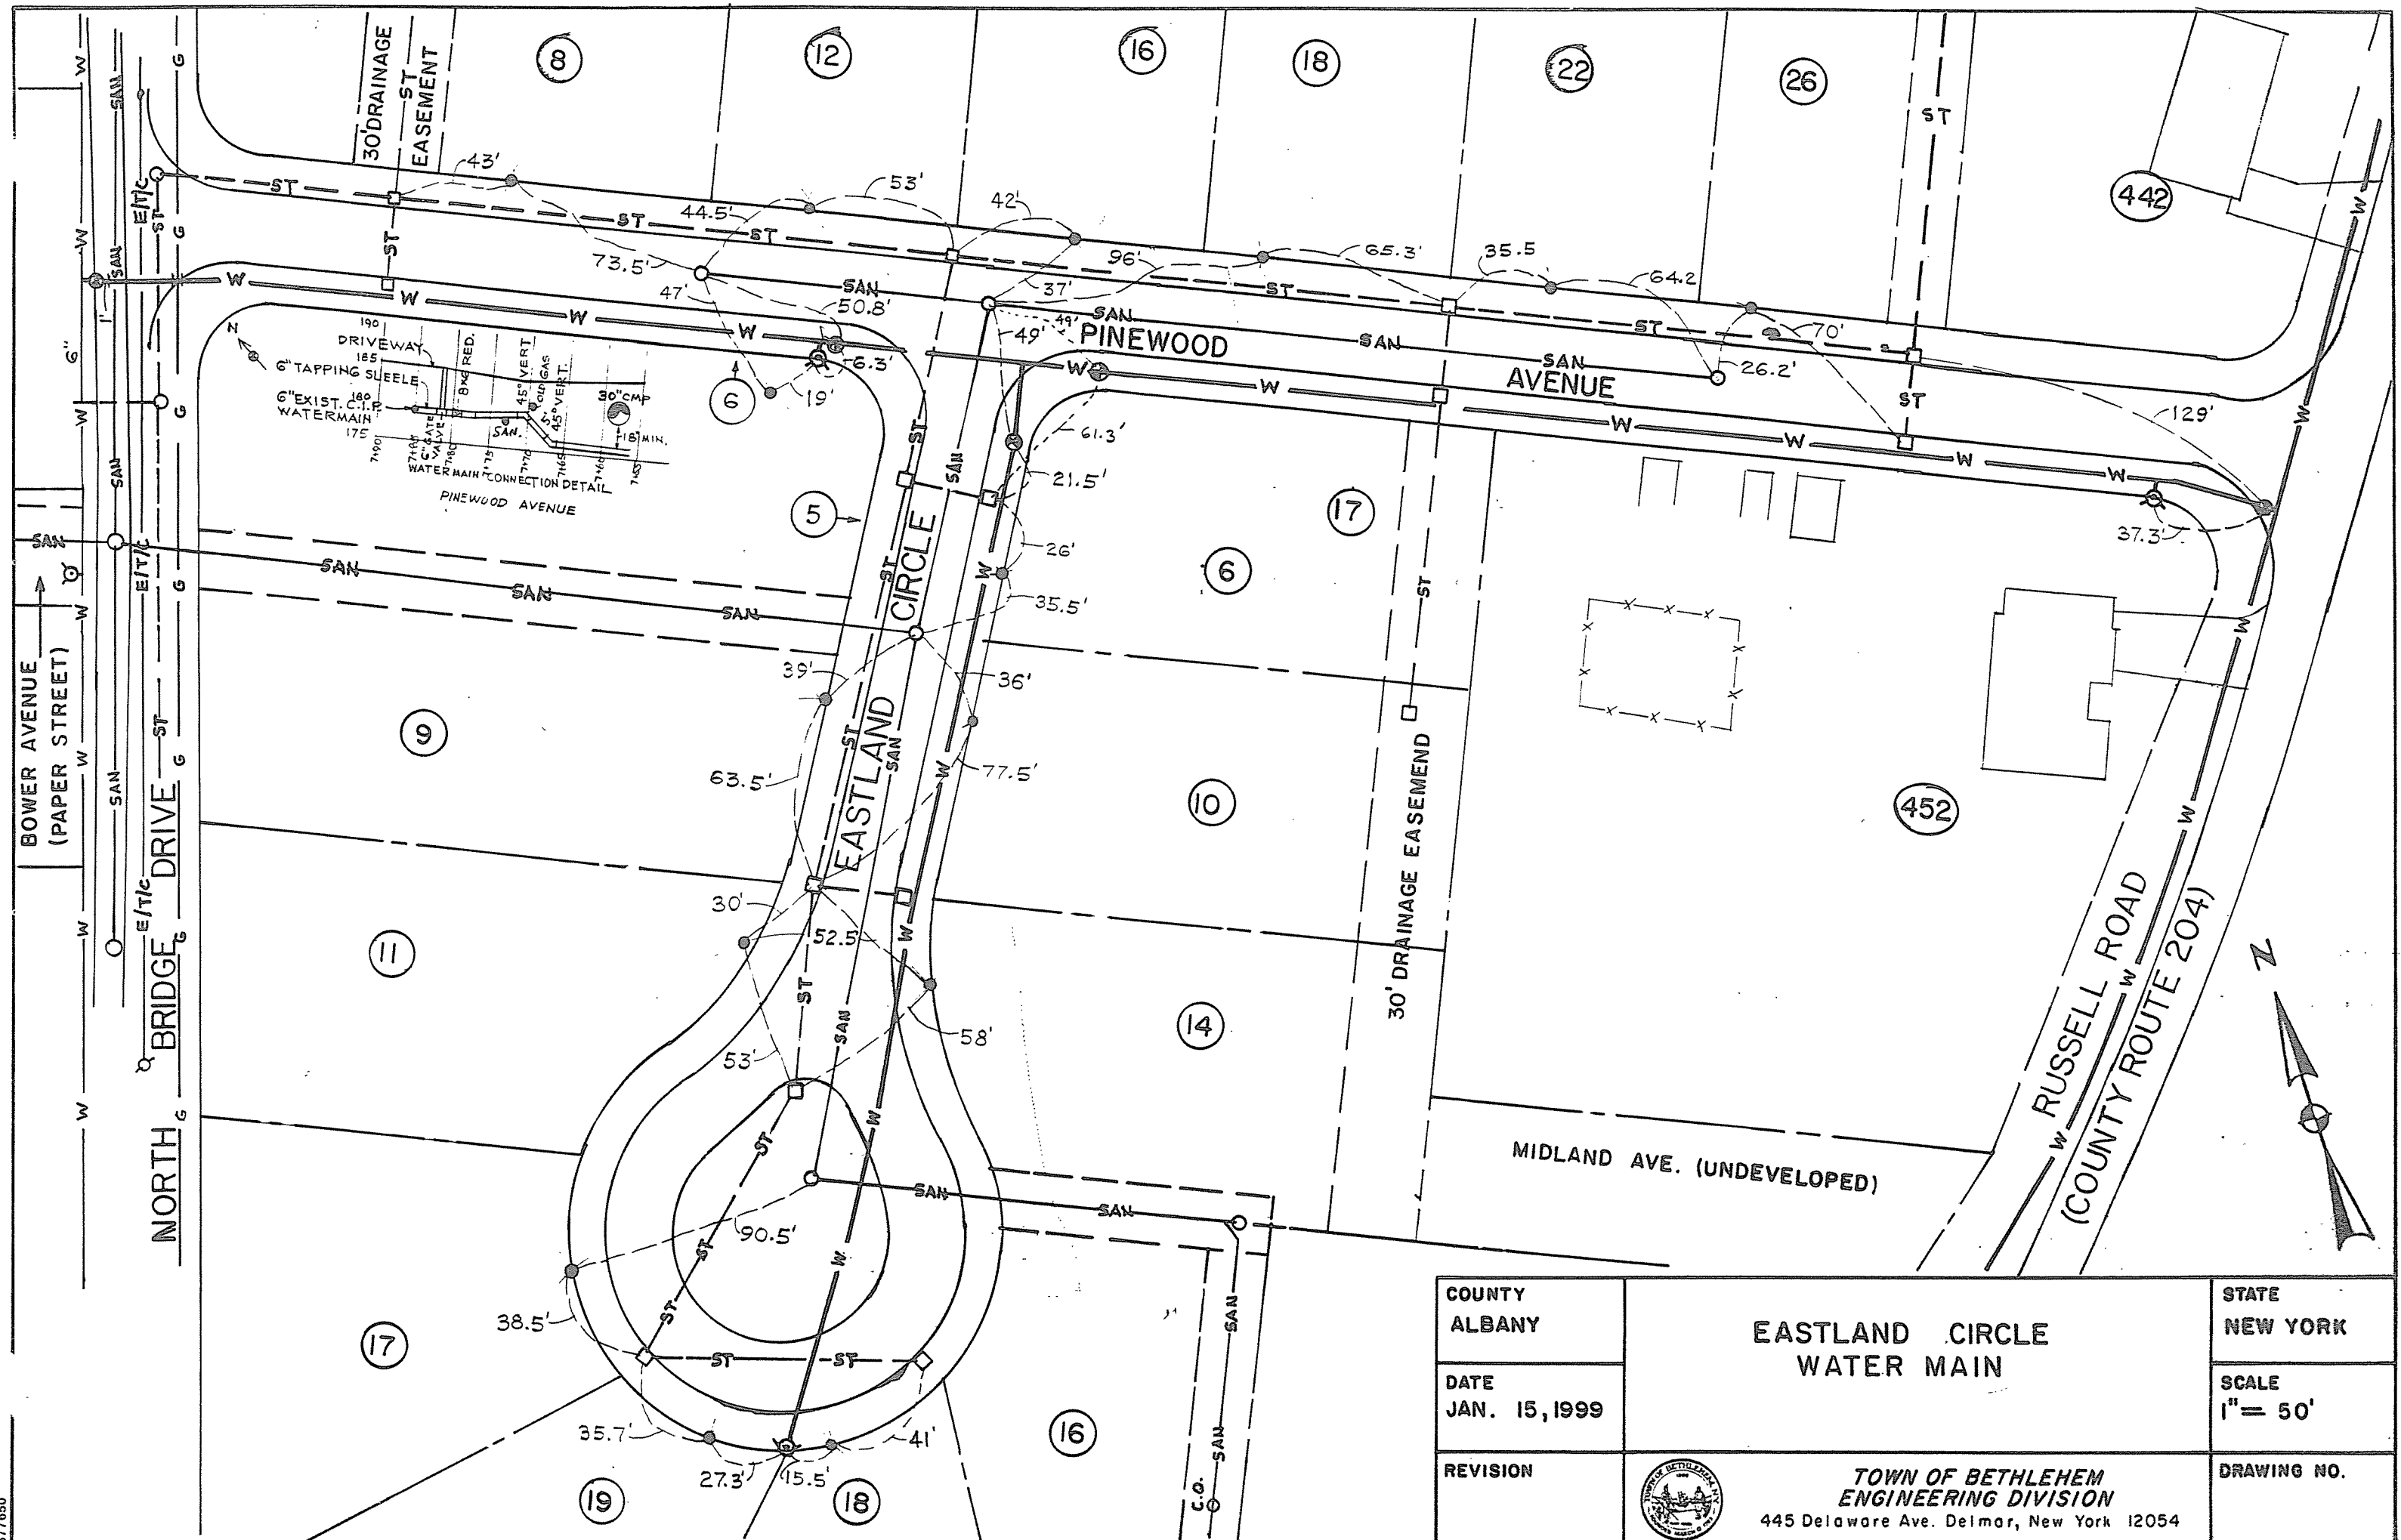

COUNTY ALBANY	EASTLAND CIRCLE WATER MAIN	STATE NEW YORK
DATE JAN. 15, 1999		SCALE 1" = 50'
REVISION	 TOWN OF BETHLEHEM ENGINEERING DIVISION 445 Delaware Ave. Delmar, New York 12054	DRAWING NO.

577050