


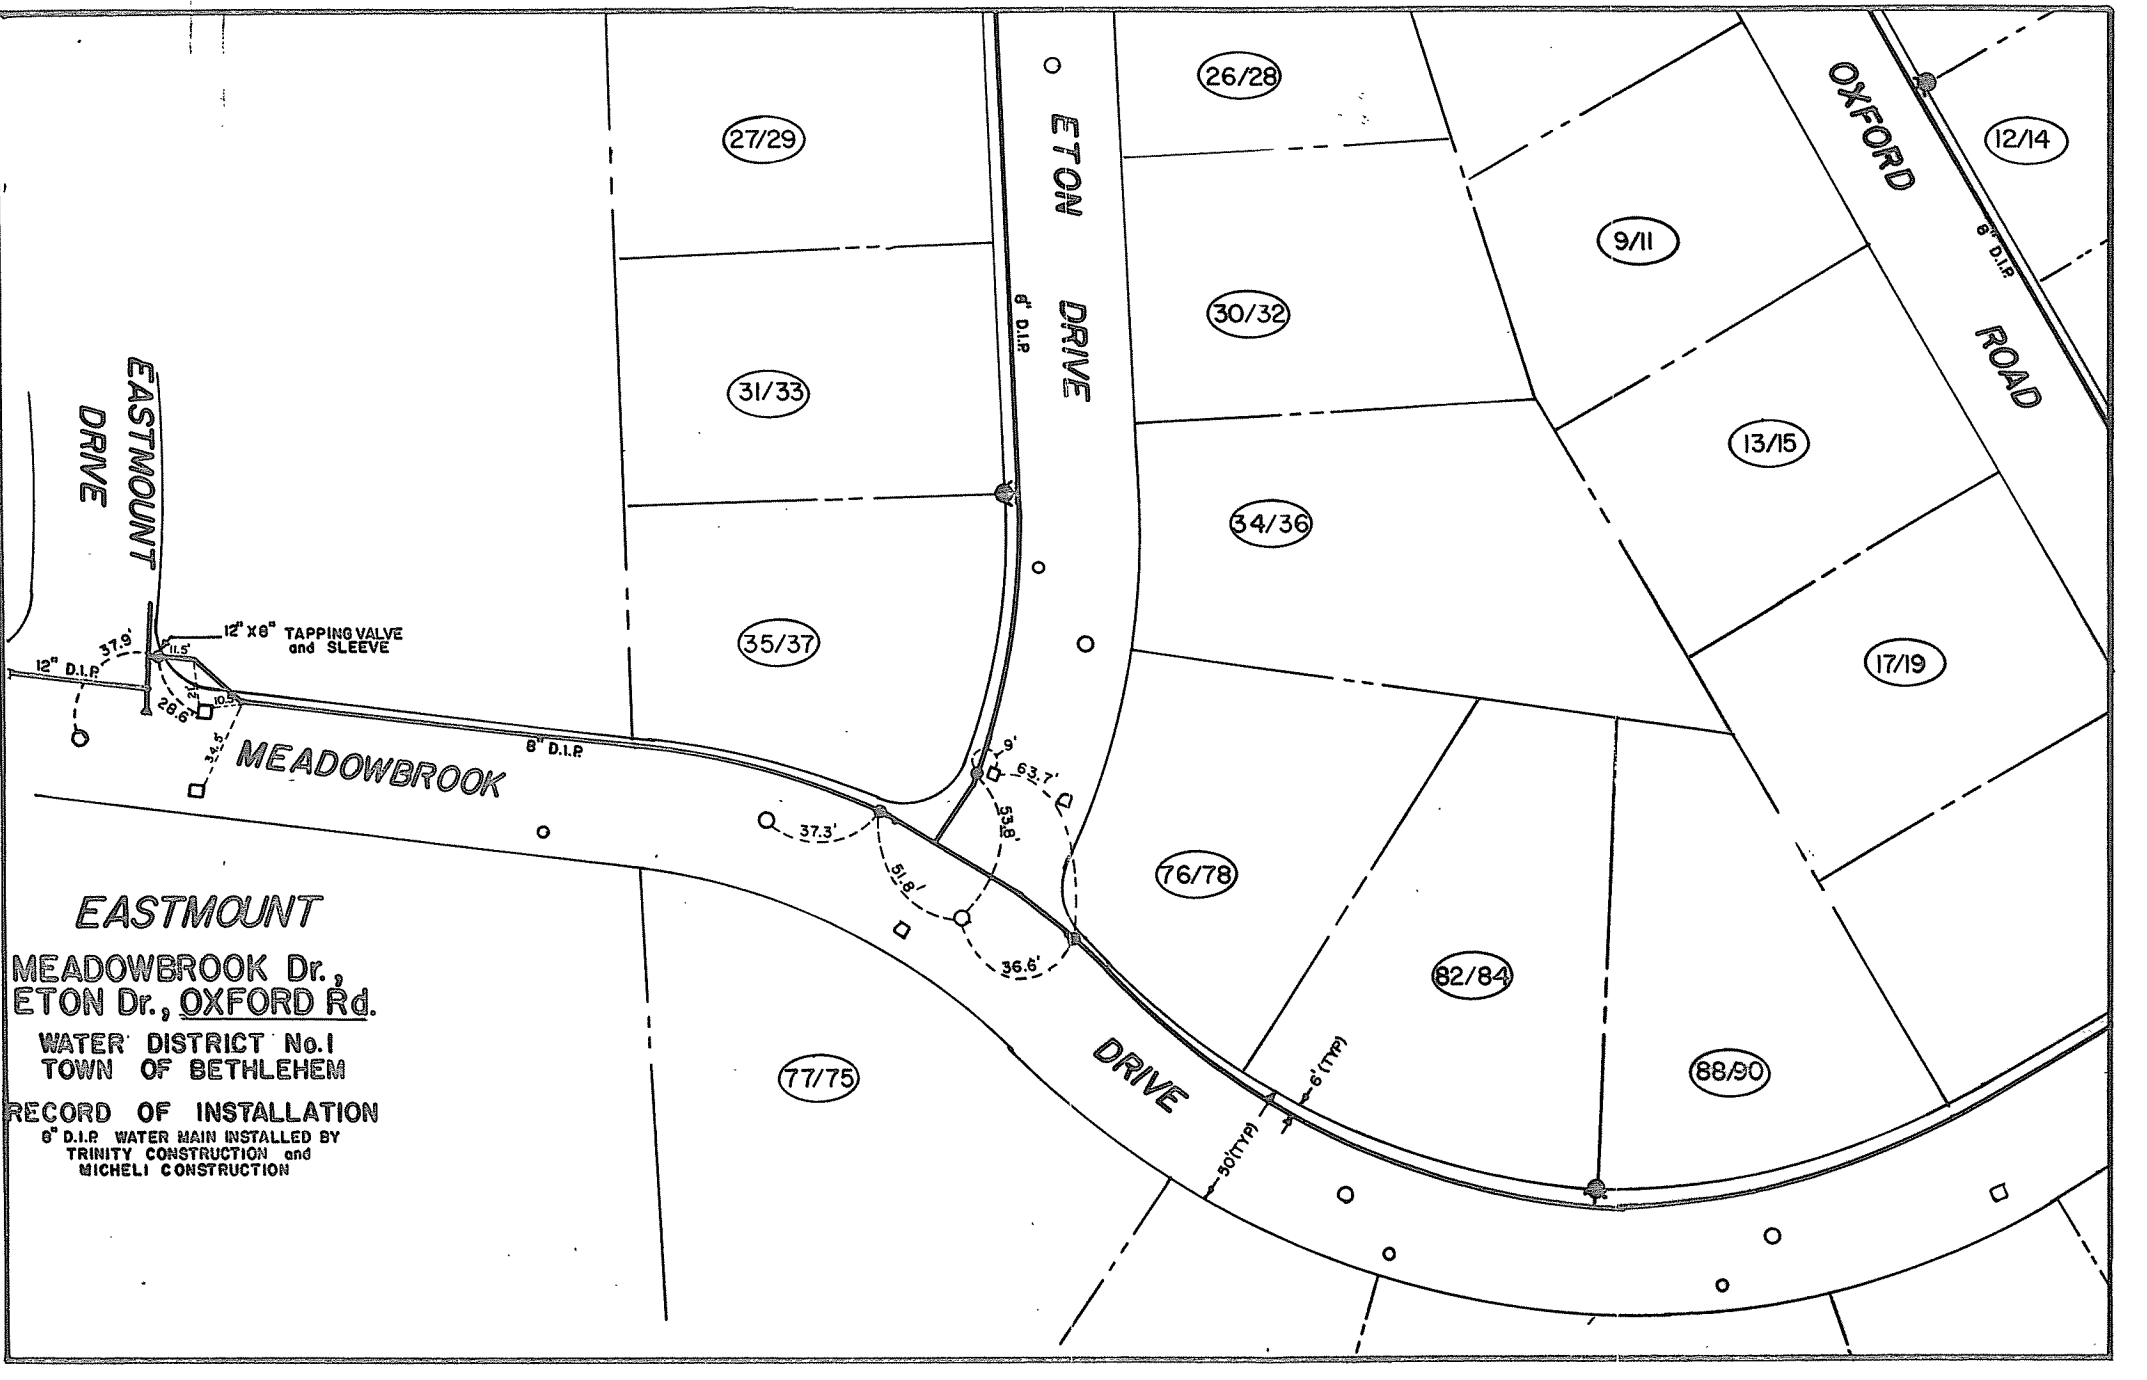

EASTMOUNT
MEADOWBROOK Dr.,
ETON Dr., OXFORD Rd.
WATER DISTRICT No.1
TOWN OF BETHLEHEM
RECORD OF INSTALLATION
6" D.I.P. WATER MAIN INSTALLED BY
TRINITY CONSTRUCTION and
MICHELI CONSTRUCTION