


EASTMOUNT
OXFORD Rd., RUGBY Rd.,
MEADOWBROOK Dr.

WATER DISTRICT No.1
TOWN OF BETHLEHEM -
RECORD OF INSTALLATION

8" D.I.P. WATER MAIN INSTALLED BY
MICHELI CONSTRUCTION
JUNE, 1985

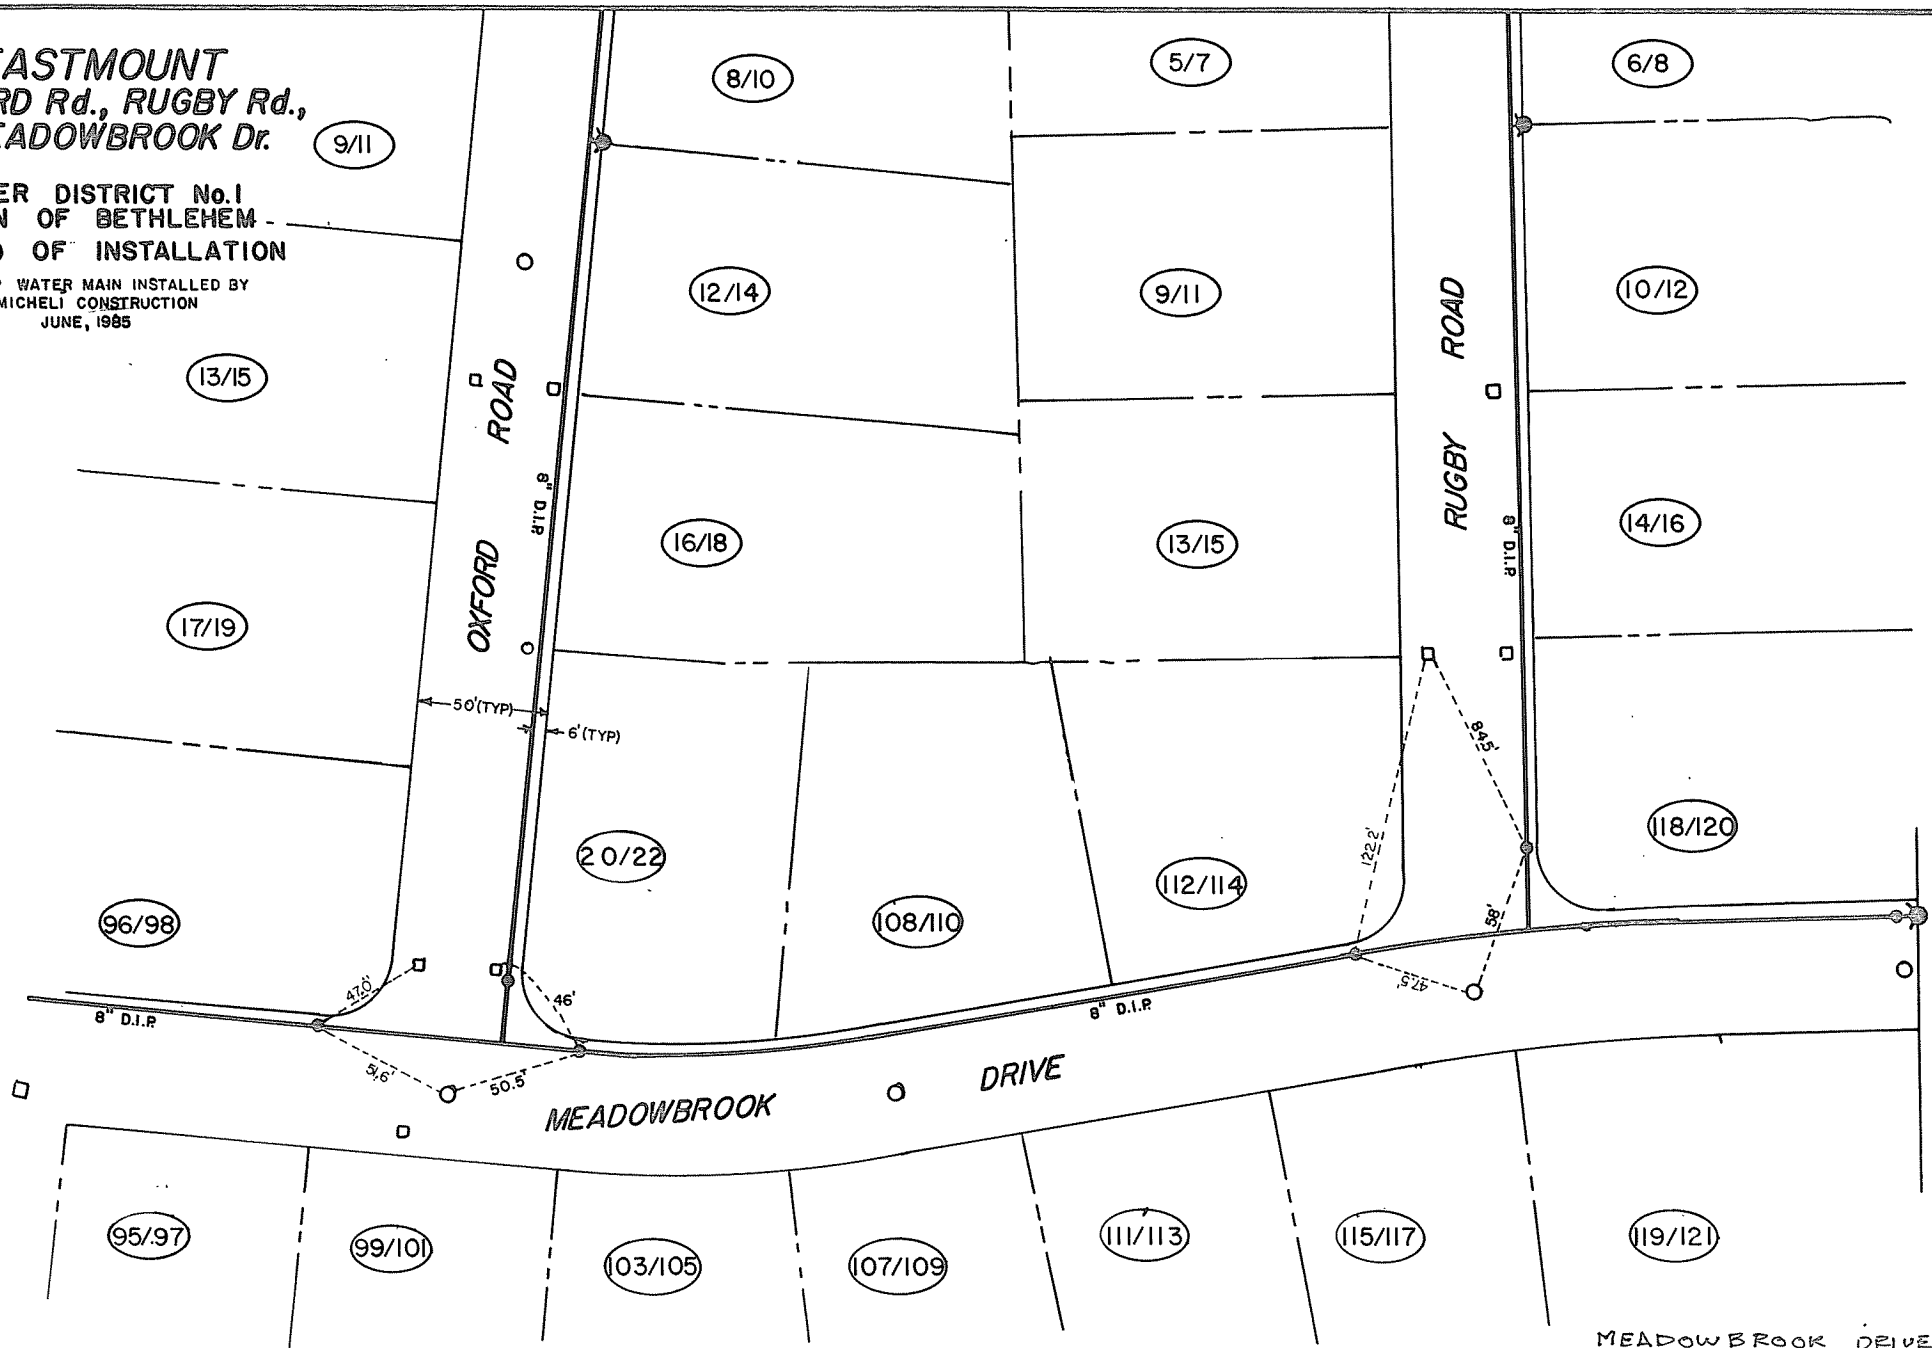

MEADOWBROOK DRIVE