


LEGEND

- CATCH BASIN
- MANHOLE
- HYDRANT
- GATE VALVE
- TEE
- THRUST BLOCK
- WATER MAIN
- ST-STORM SEWER
- SA-SANITARY SEWER
- CURB BOX

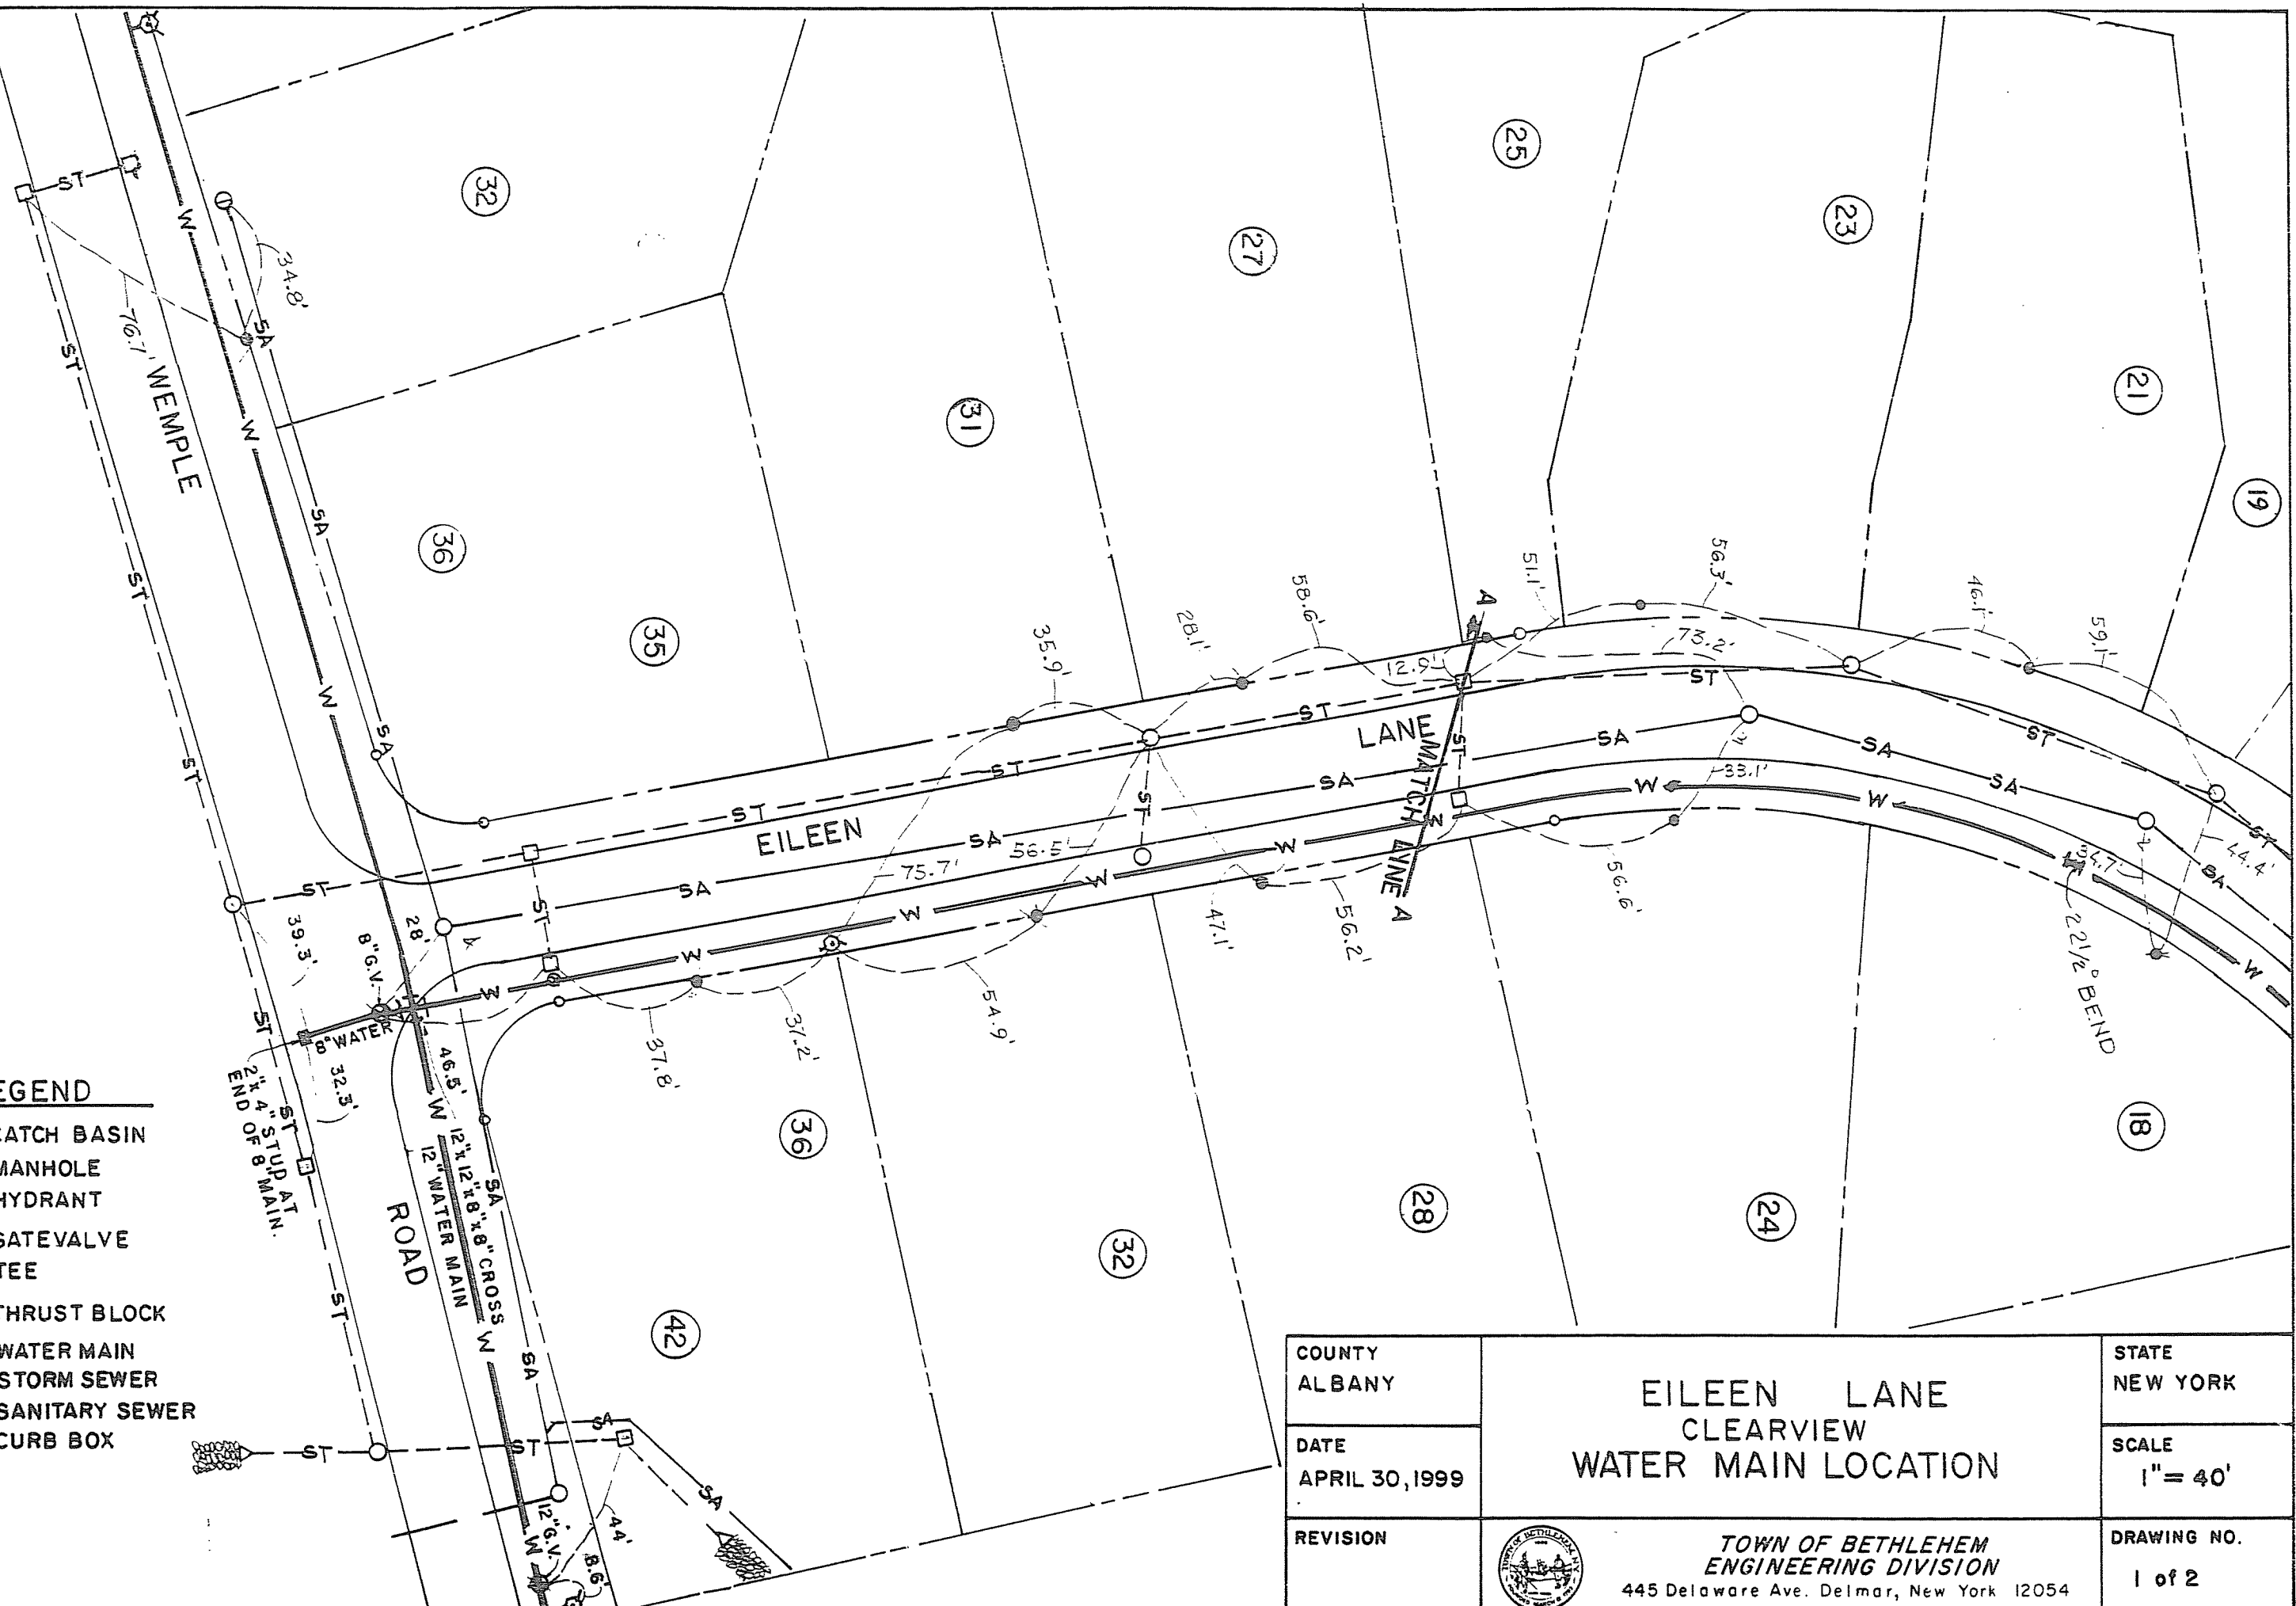

COUNTY ALBANY	EILEEN LANE CLEARVIEW WATER MAIN LOCATION	STATE NEW YORK
DATE APRIL 30, 1999		SCALE 1" = 40'
REVISION	 TOWN OF BETHLEHEM ENGINEERING DIVISION 445 Delaware Ave. Delmar, New York 12054	DRAWING NO. 1 of 2