



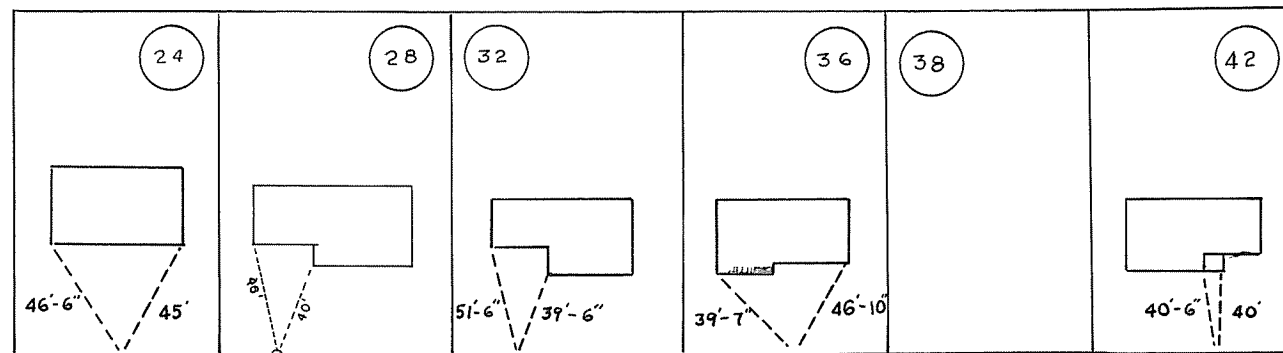

ELLENDALE
AVENUE

ELLENDALE AVENUE

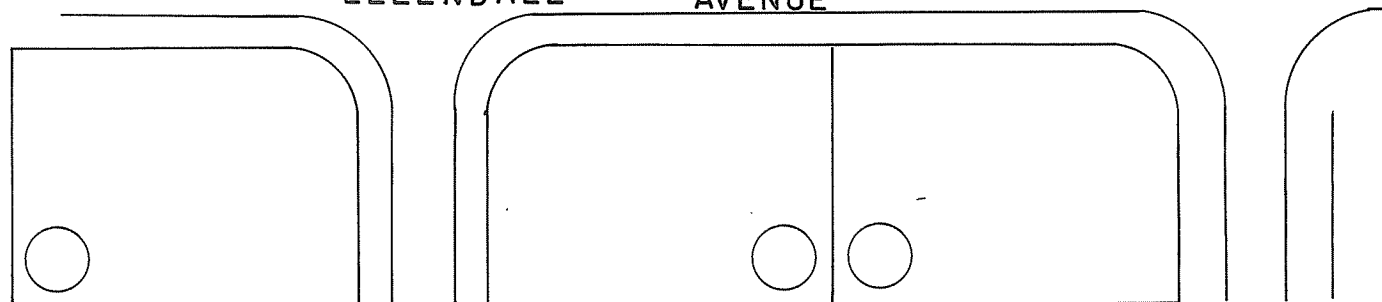

SCALE. 1" = 50'		DRAWING NUMBER.
DRAWN BY. R E B		
APPROVED.		
DATE.		
	TOWN OF BETHLEHEM	
	ENGINEERING DEPARTMENT	
445 DELAWARE AVE. DELMAR, NEW YORK 12004		