

DRIVE

FAIRLAWN

6




10

12

16

18

22

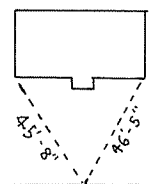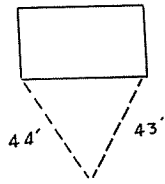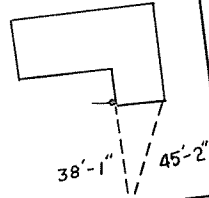

ELLENDALE

AVENUE

ELLENDALE AVE

SCALE 1" = 50'	
DRAWN BY REB	
APPROVED	
DATE	
	TOWN OF BETHEL, NEW HAMPSHIRE
	ENGINEERING DEPARTMENT
	145 DELAWARE AVE. BETHEL, NEW HAMPSHIRE 03754