


48

MILBURN
JOHN S
LORNA

TOWN HIGHWAY GA:

74

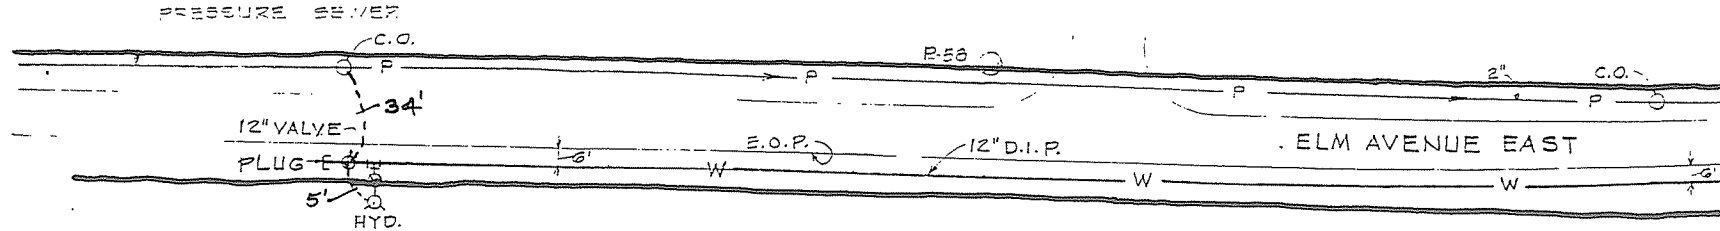

BATES

49

THESE HOUSES PRESENTL

WINDMILL DRIVE

ORIGINAL

PROPOSED ELM AVE EAST
WATER MAIN EXTENSION

TOWN OF BETHLEHEM

ALBANY COUNTY • NEW YORK

DEPARTMENT OF PUBLIC WORKS

445 DELAWARE AVENUE
DELMAR, NEW YORK 12054



DATE: MAY 17, 1995

PLAN
SCALE: 1" = 50'