


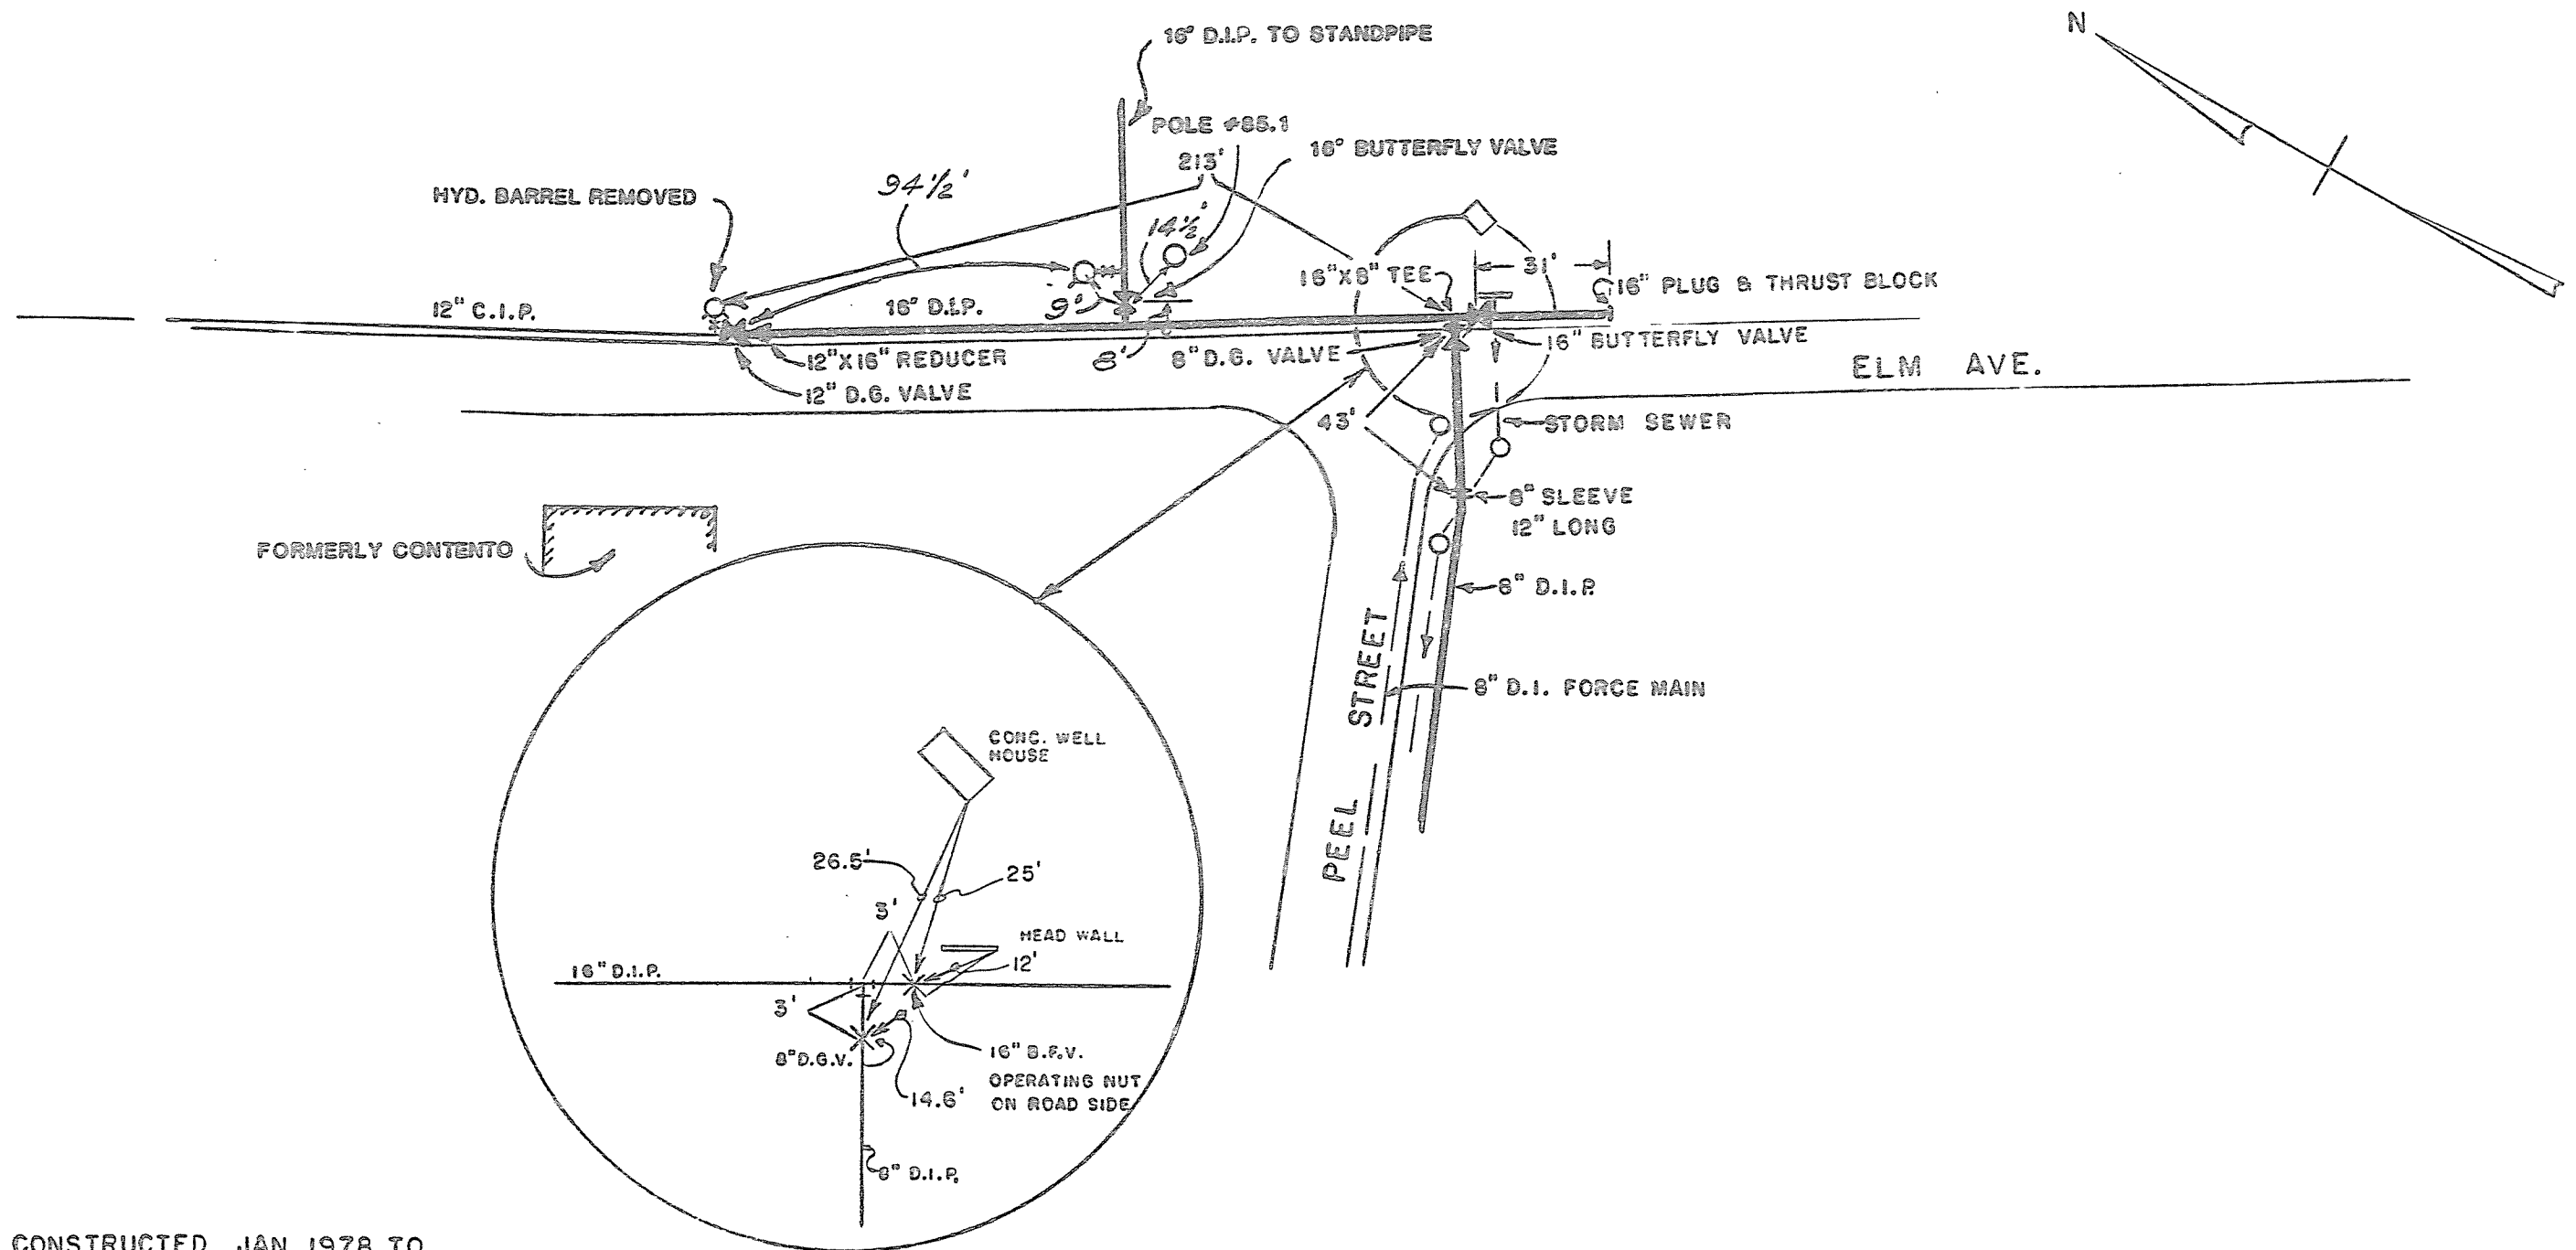

CONSTRUCTED JAN. 1978 TO
 FEB. 1978
 CONTRACTOR: HARLEN METZ
 SOIL: 1' TO 3' OF SAND ON
 TOP OF SHALE LEDGE

DRAWN BY: H.P.J.
 CHECKED BY: W.T.B.

REV. JUN. 1980

ELM AVENUE EXTENSION
 WATER DISTRICT NO. 1
 TOWN OF BETHLEHEM
 RECORD OF INSTALLATION
 SCALE: 1" = 50' APRIL 1978
 J. KENNETH FRASER & ASSOCIATES, P.C.
 CONSULTING ENGINEERS RENSSELAER, N.Y.