


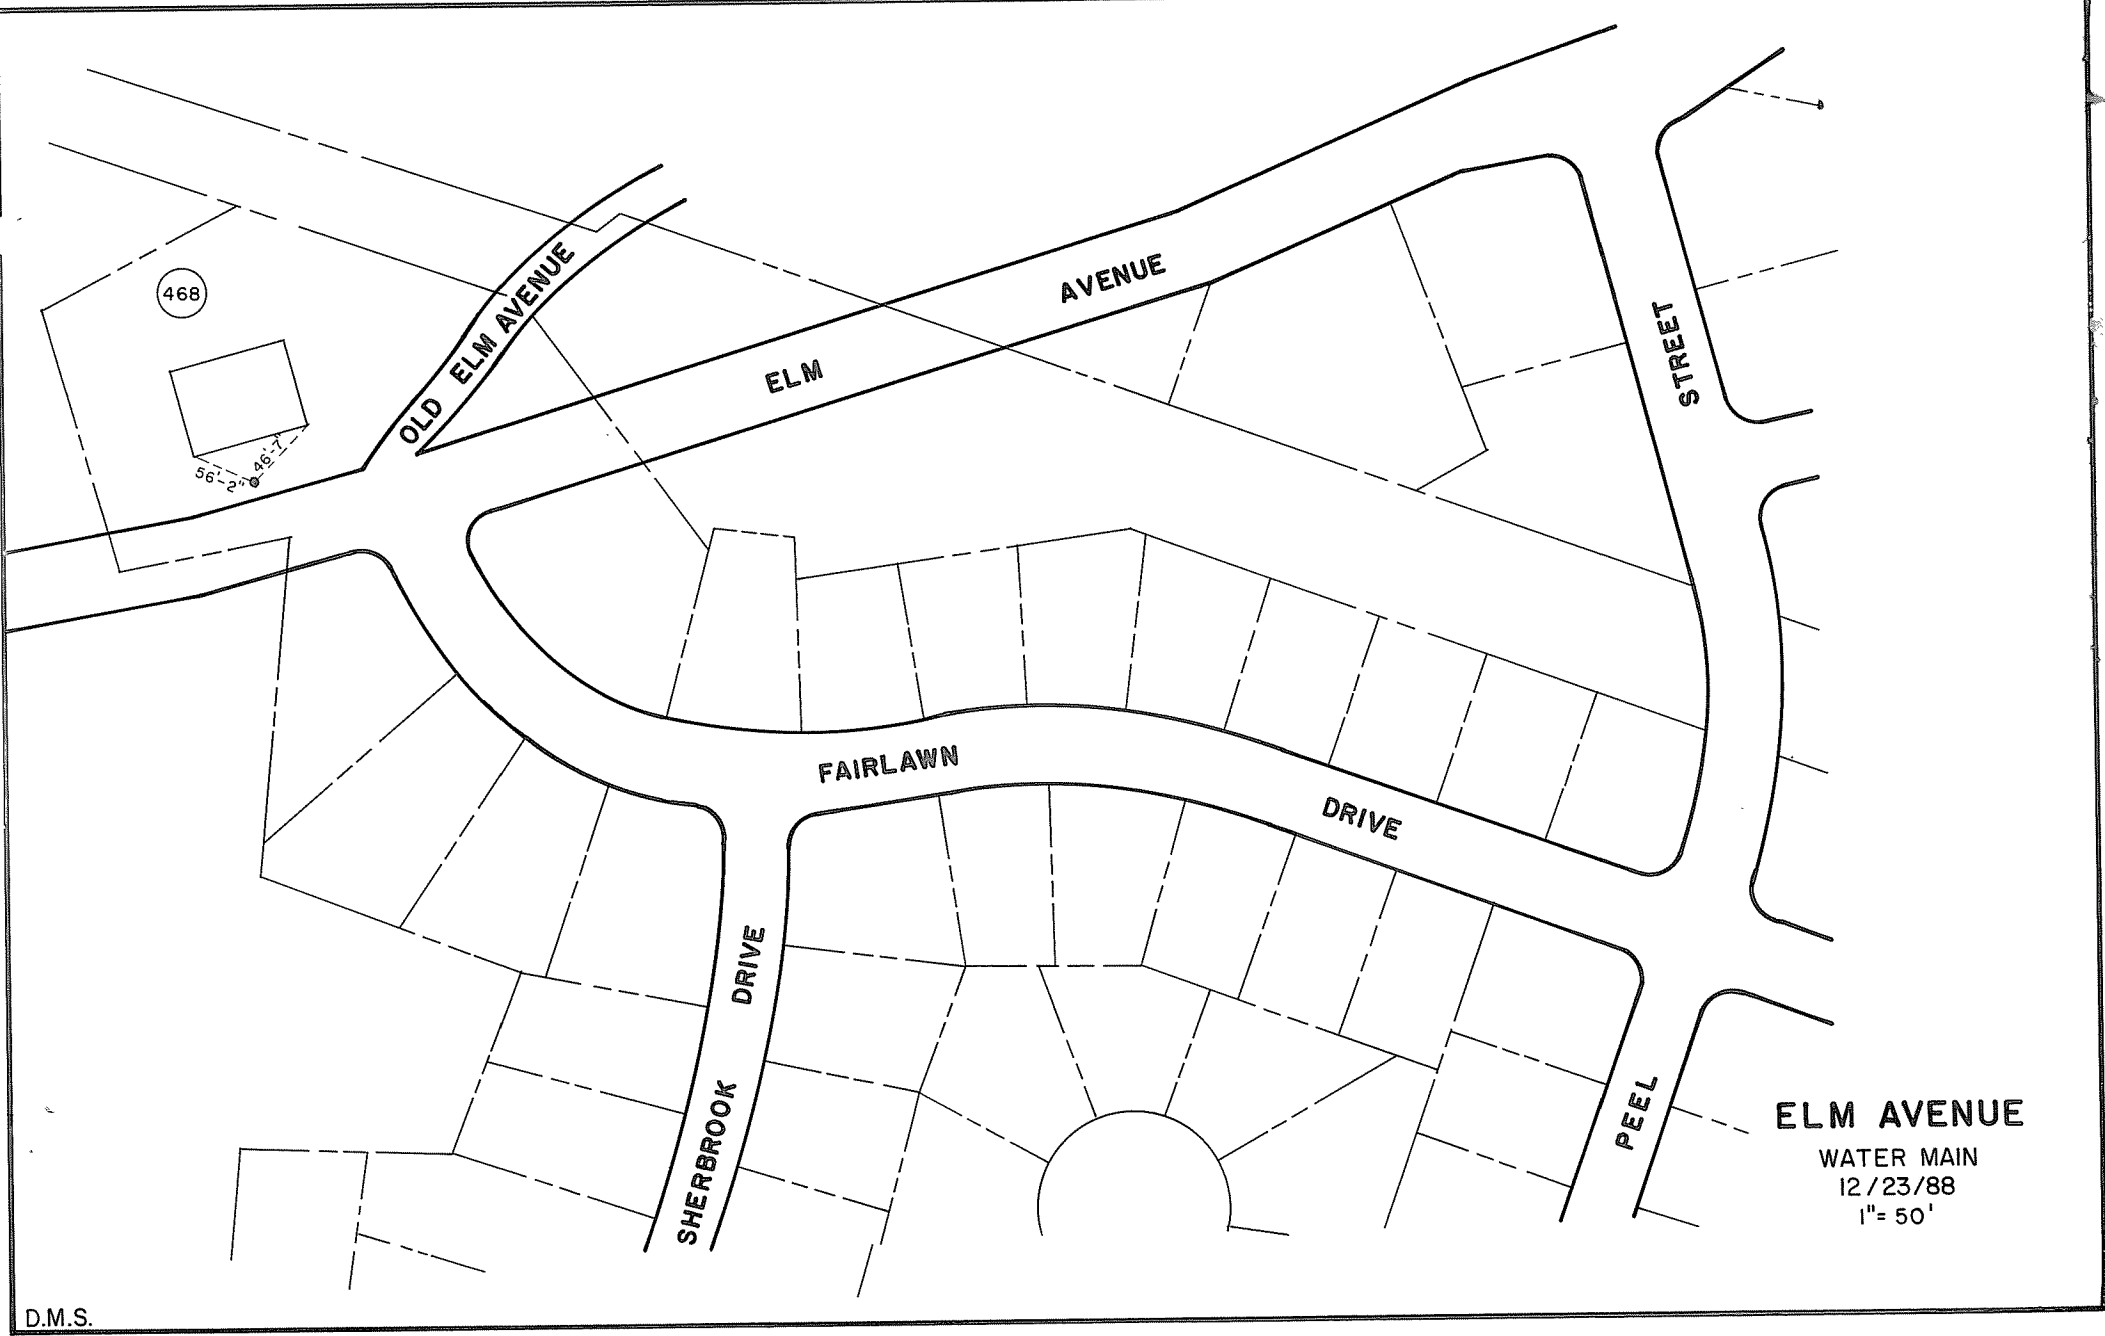

ELM AVENUE

WATER MAIN

12/23/88

1"= 50'