
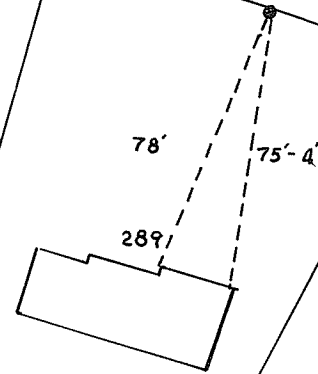
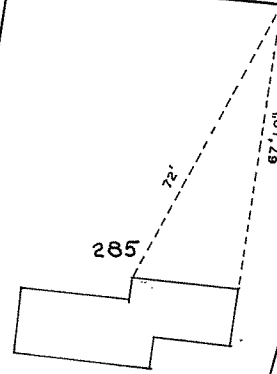
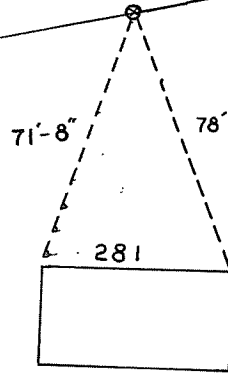


AVENUE

ELM

ELM AVENUE

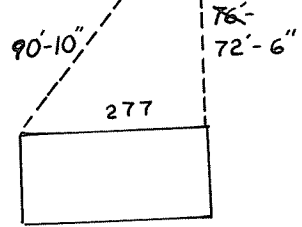

SCALE 1" = 30'		TOWN OF BETHLEHEM ENGINEERING DEPARTMENT 446 DELAWARE AVE. DELMAR, NEW YORK 12024
DRAWN BY. REB		
APPROVED.		
DATE.		
		OFFICIAL POWER