


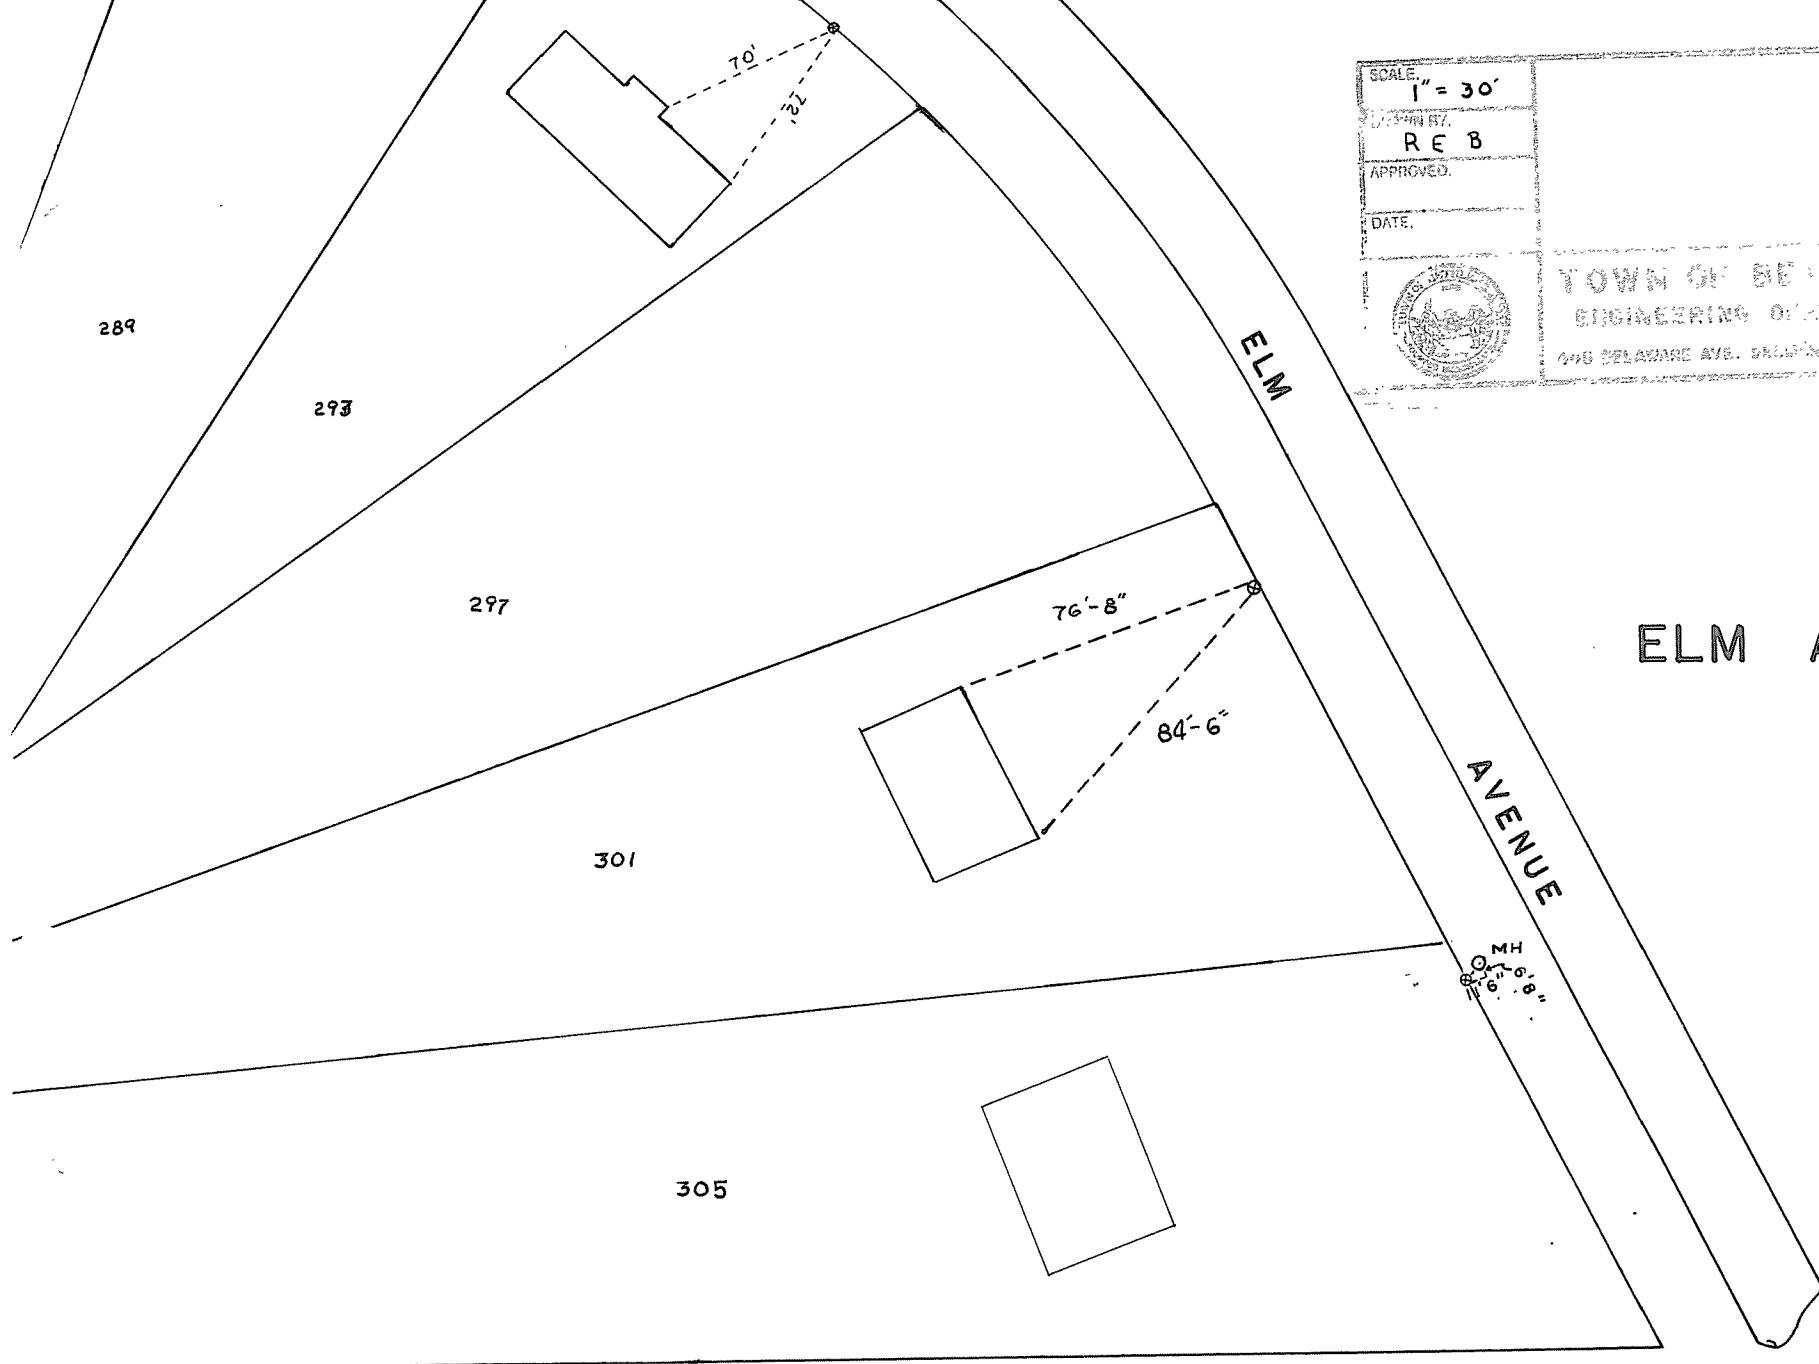

SCALE. 1" = 30'	
RECEIVED BY. RE B	
APPROVED.	
DATE.	
	TOWN OF BETHLEHEM
	ENGINEERING DEPARTMENT
440 DELAWARE AVE. BETHLEHEM, PENN. 18013	

ELM AVENUE