


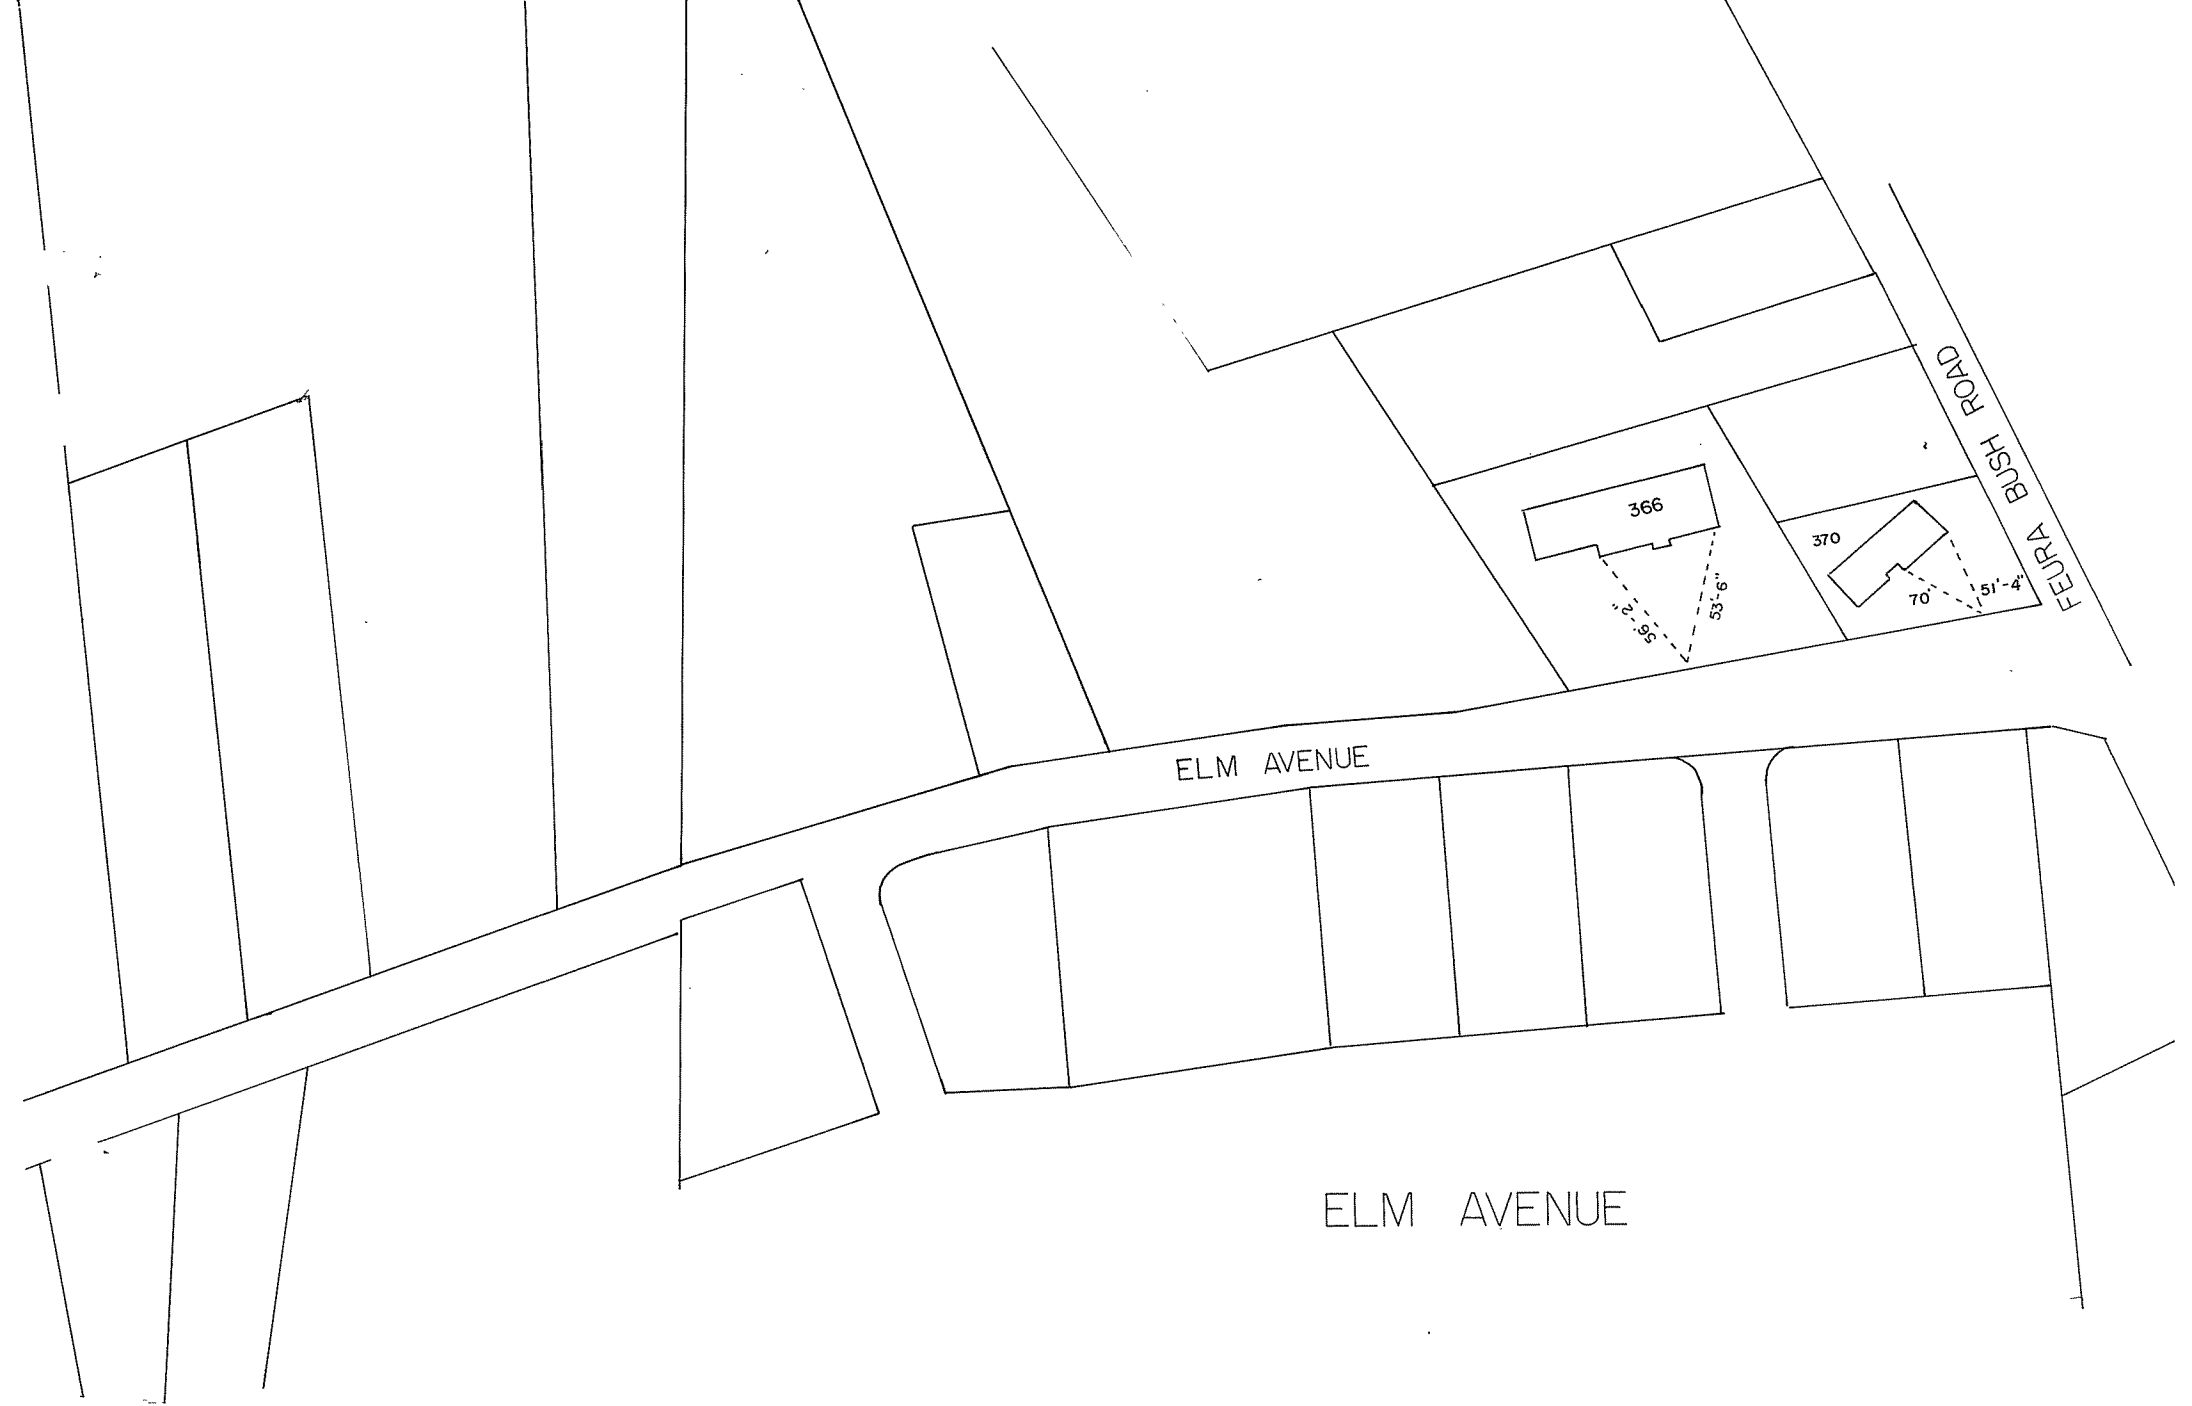

ELM AVENUE

ELM AVENUE

FEURA BUSH ROAD

366

370

53'-6"

5'-9"

70'

51'-4"