


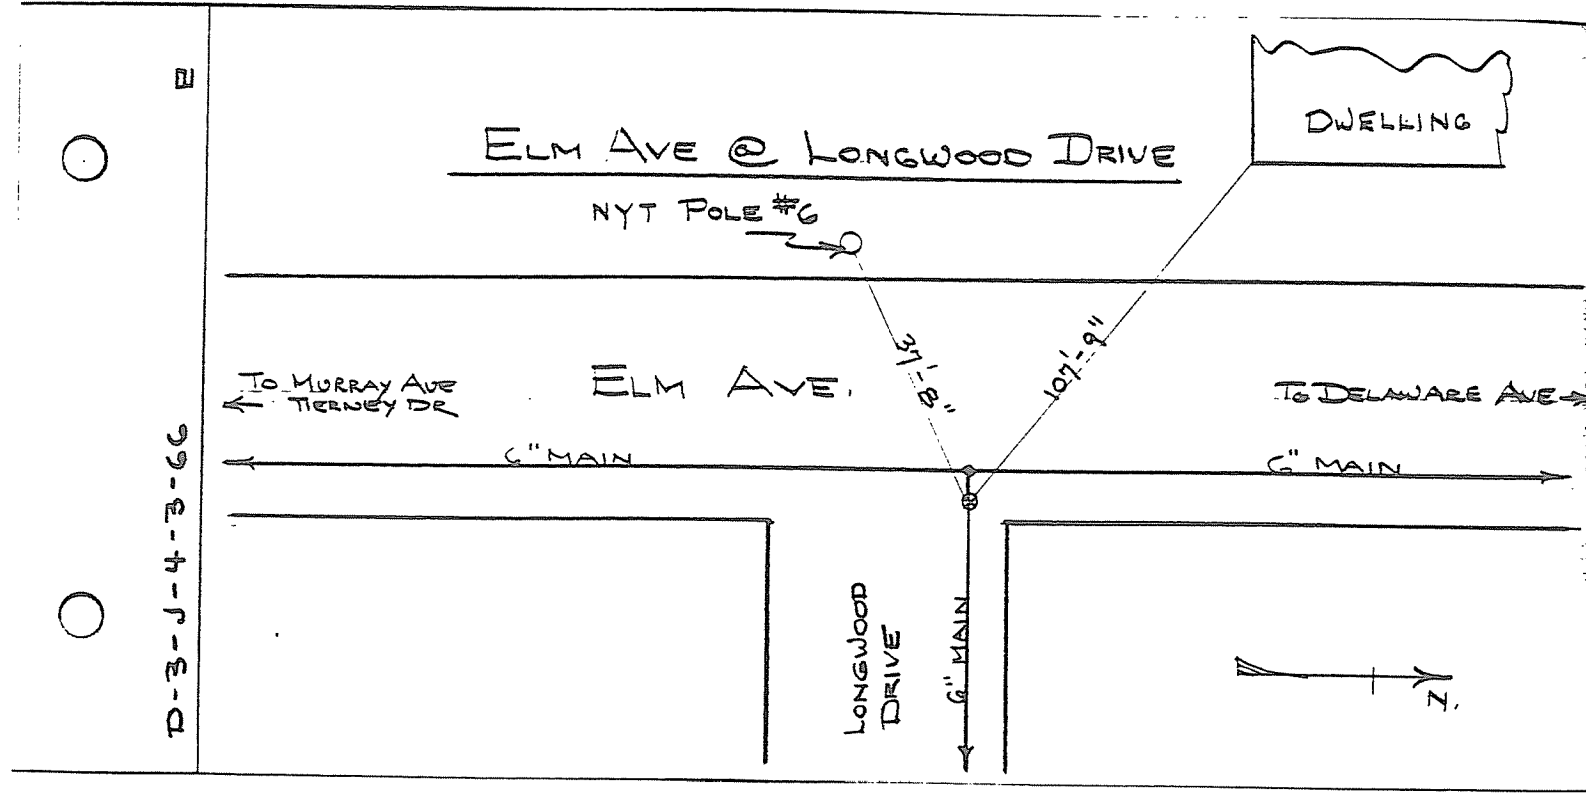

ELM AVENUE
WATER MAIN