



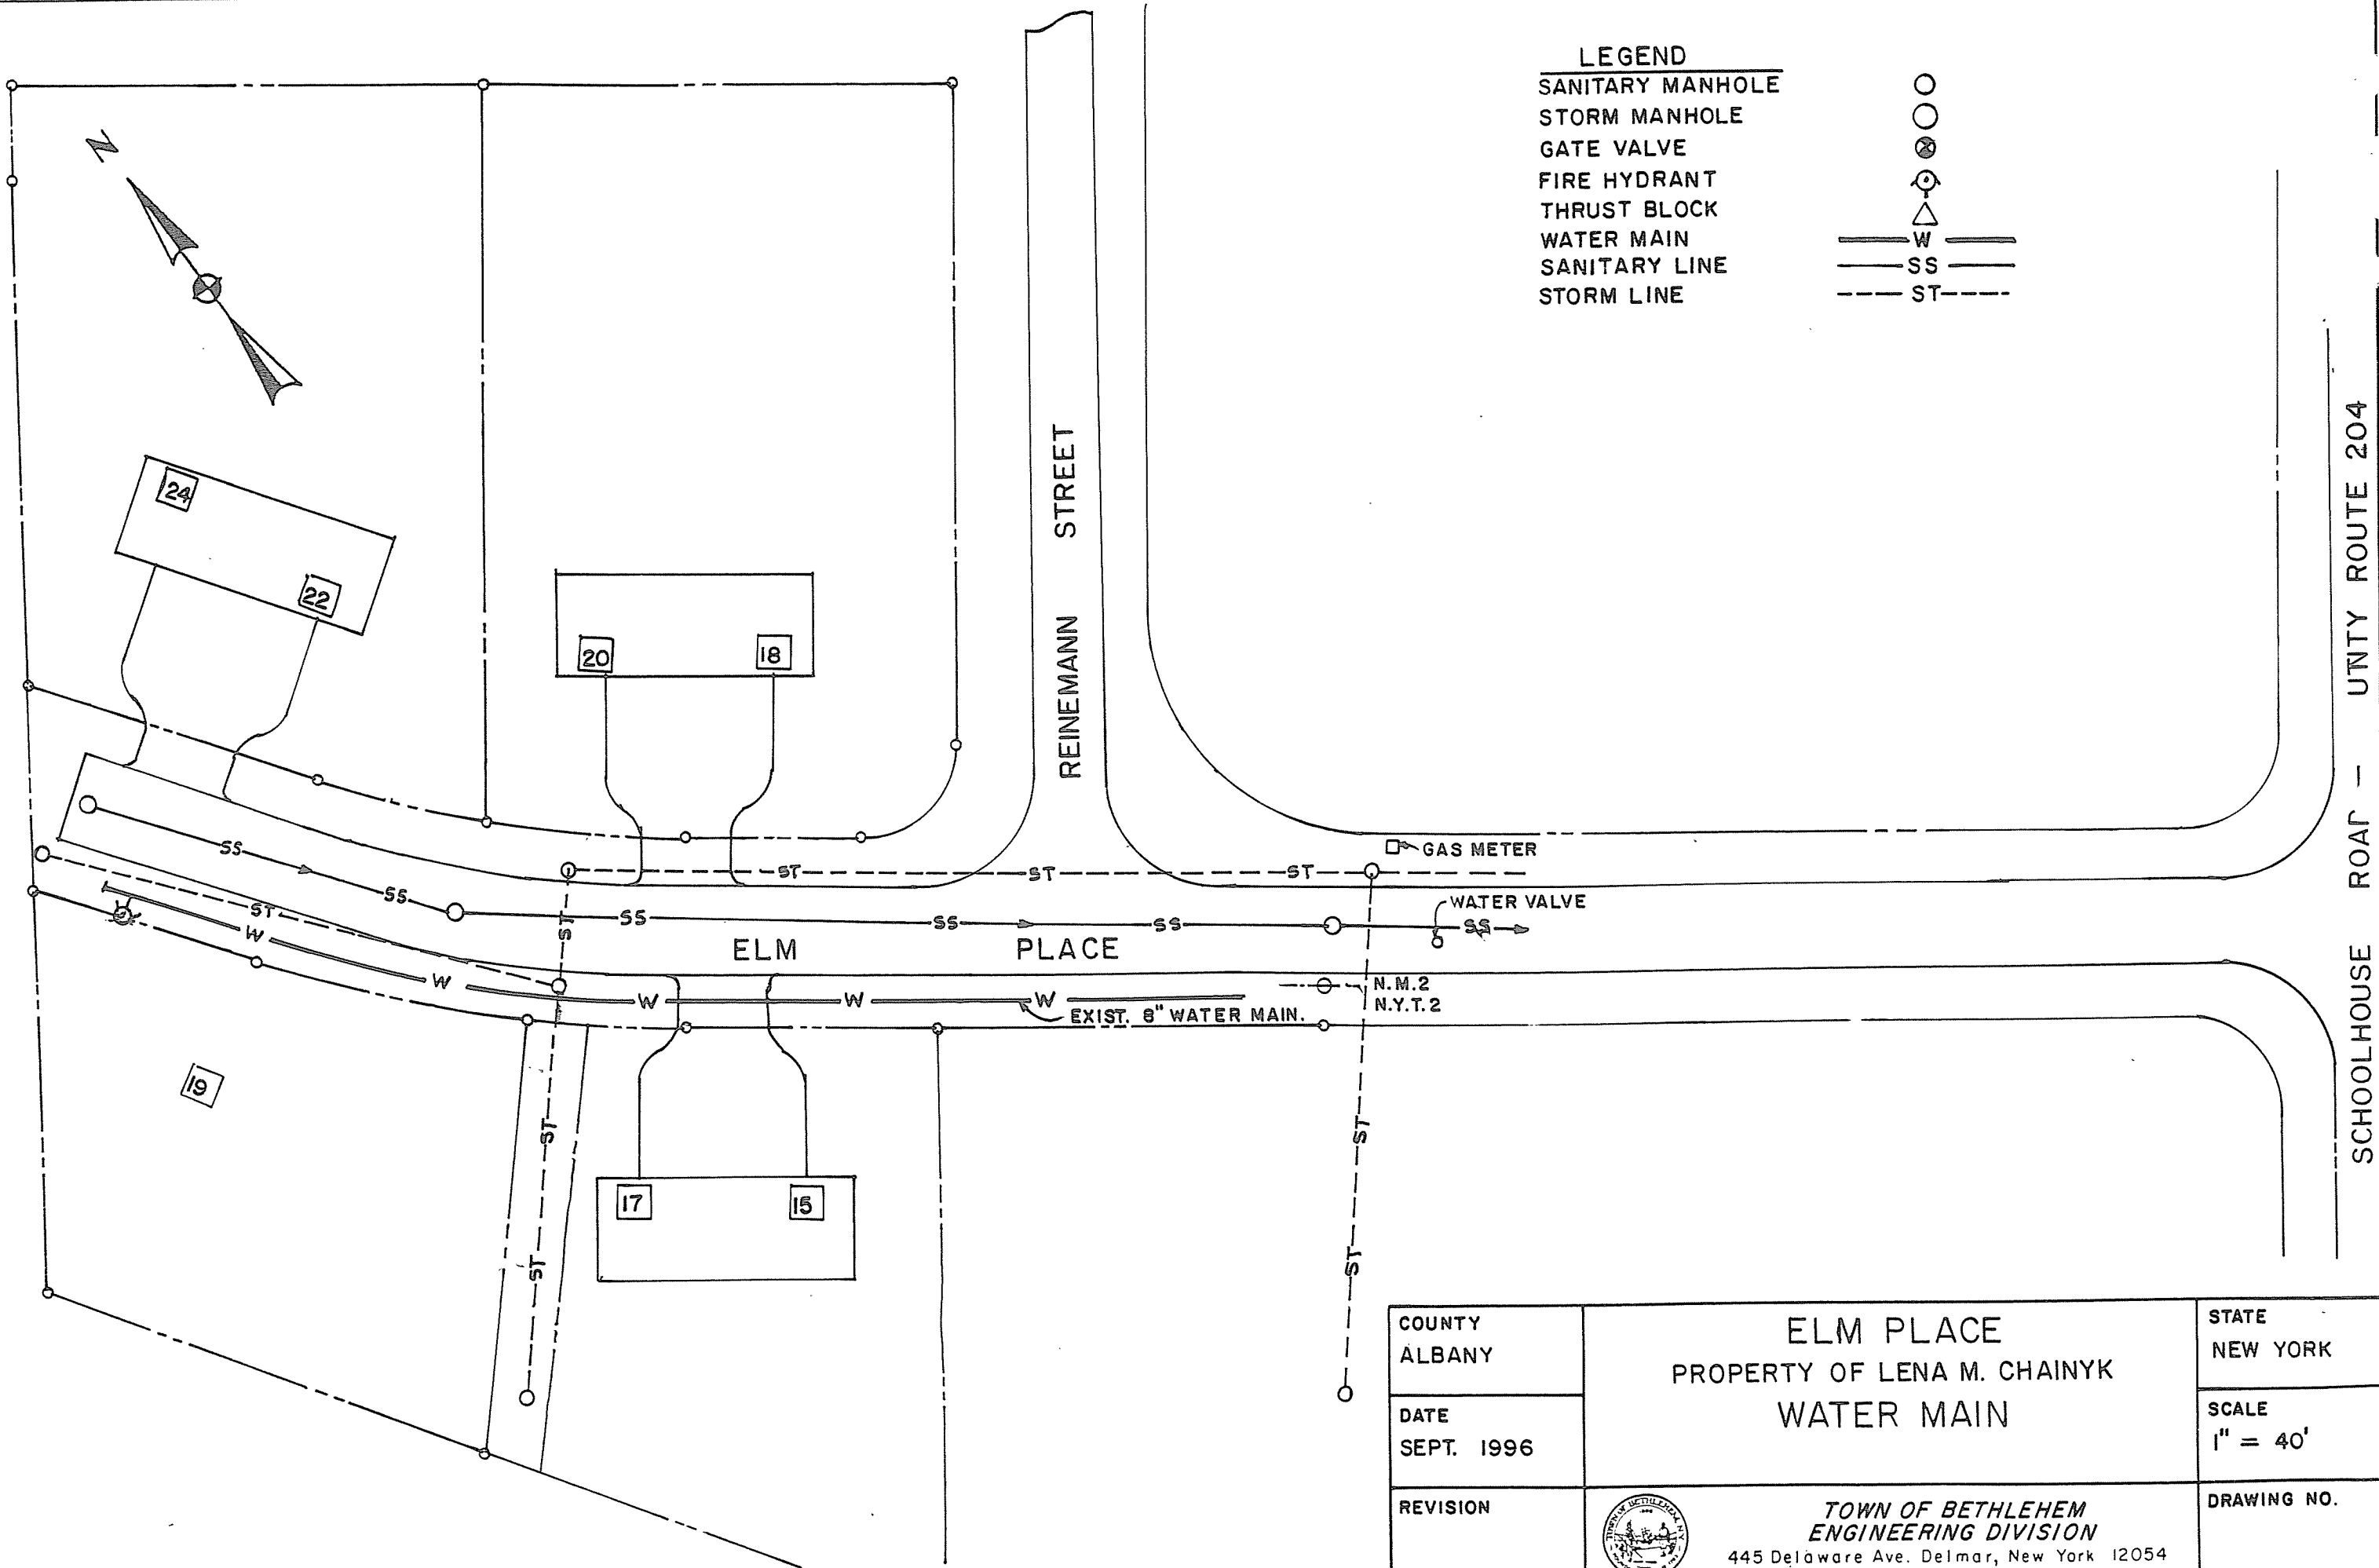

- LEGEND**
- SANITARY MANHOLE
 - STORM MANHOLE
 - GATE VALVE
 - FIRE HYDRANT
 - THRUST BLOCK
 - WATER MAIN
 - SANITARY LINE
 - STORM LINE

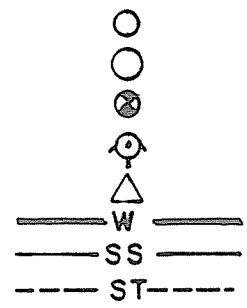

COUNTY ALBANY	ELM PLACE PROPERTY OF LENA M. CHAINYK WATER MAIN	STATE NEW YORK
DATE SEPT. 1996		SCALE 1" = 40'
REVISION	 TOWN OF BETHLEHEM ENGINEERING DIVISION 445 Delaware Ave. Delmar, New York 12054	DRAWING NO.