


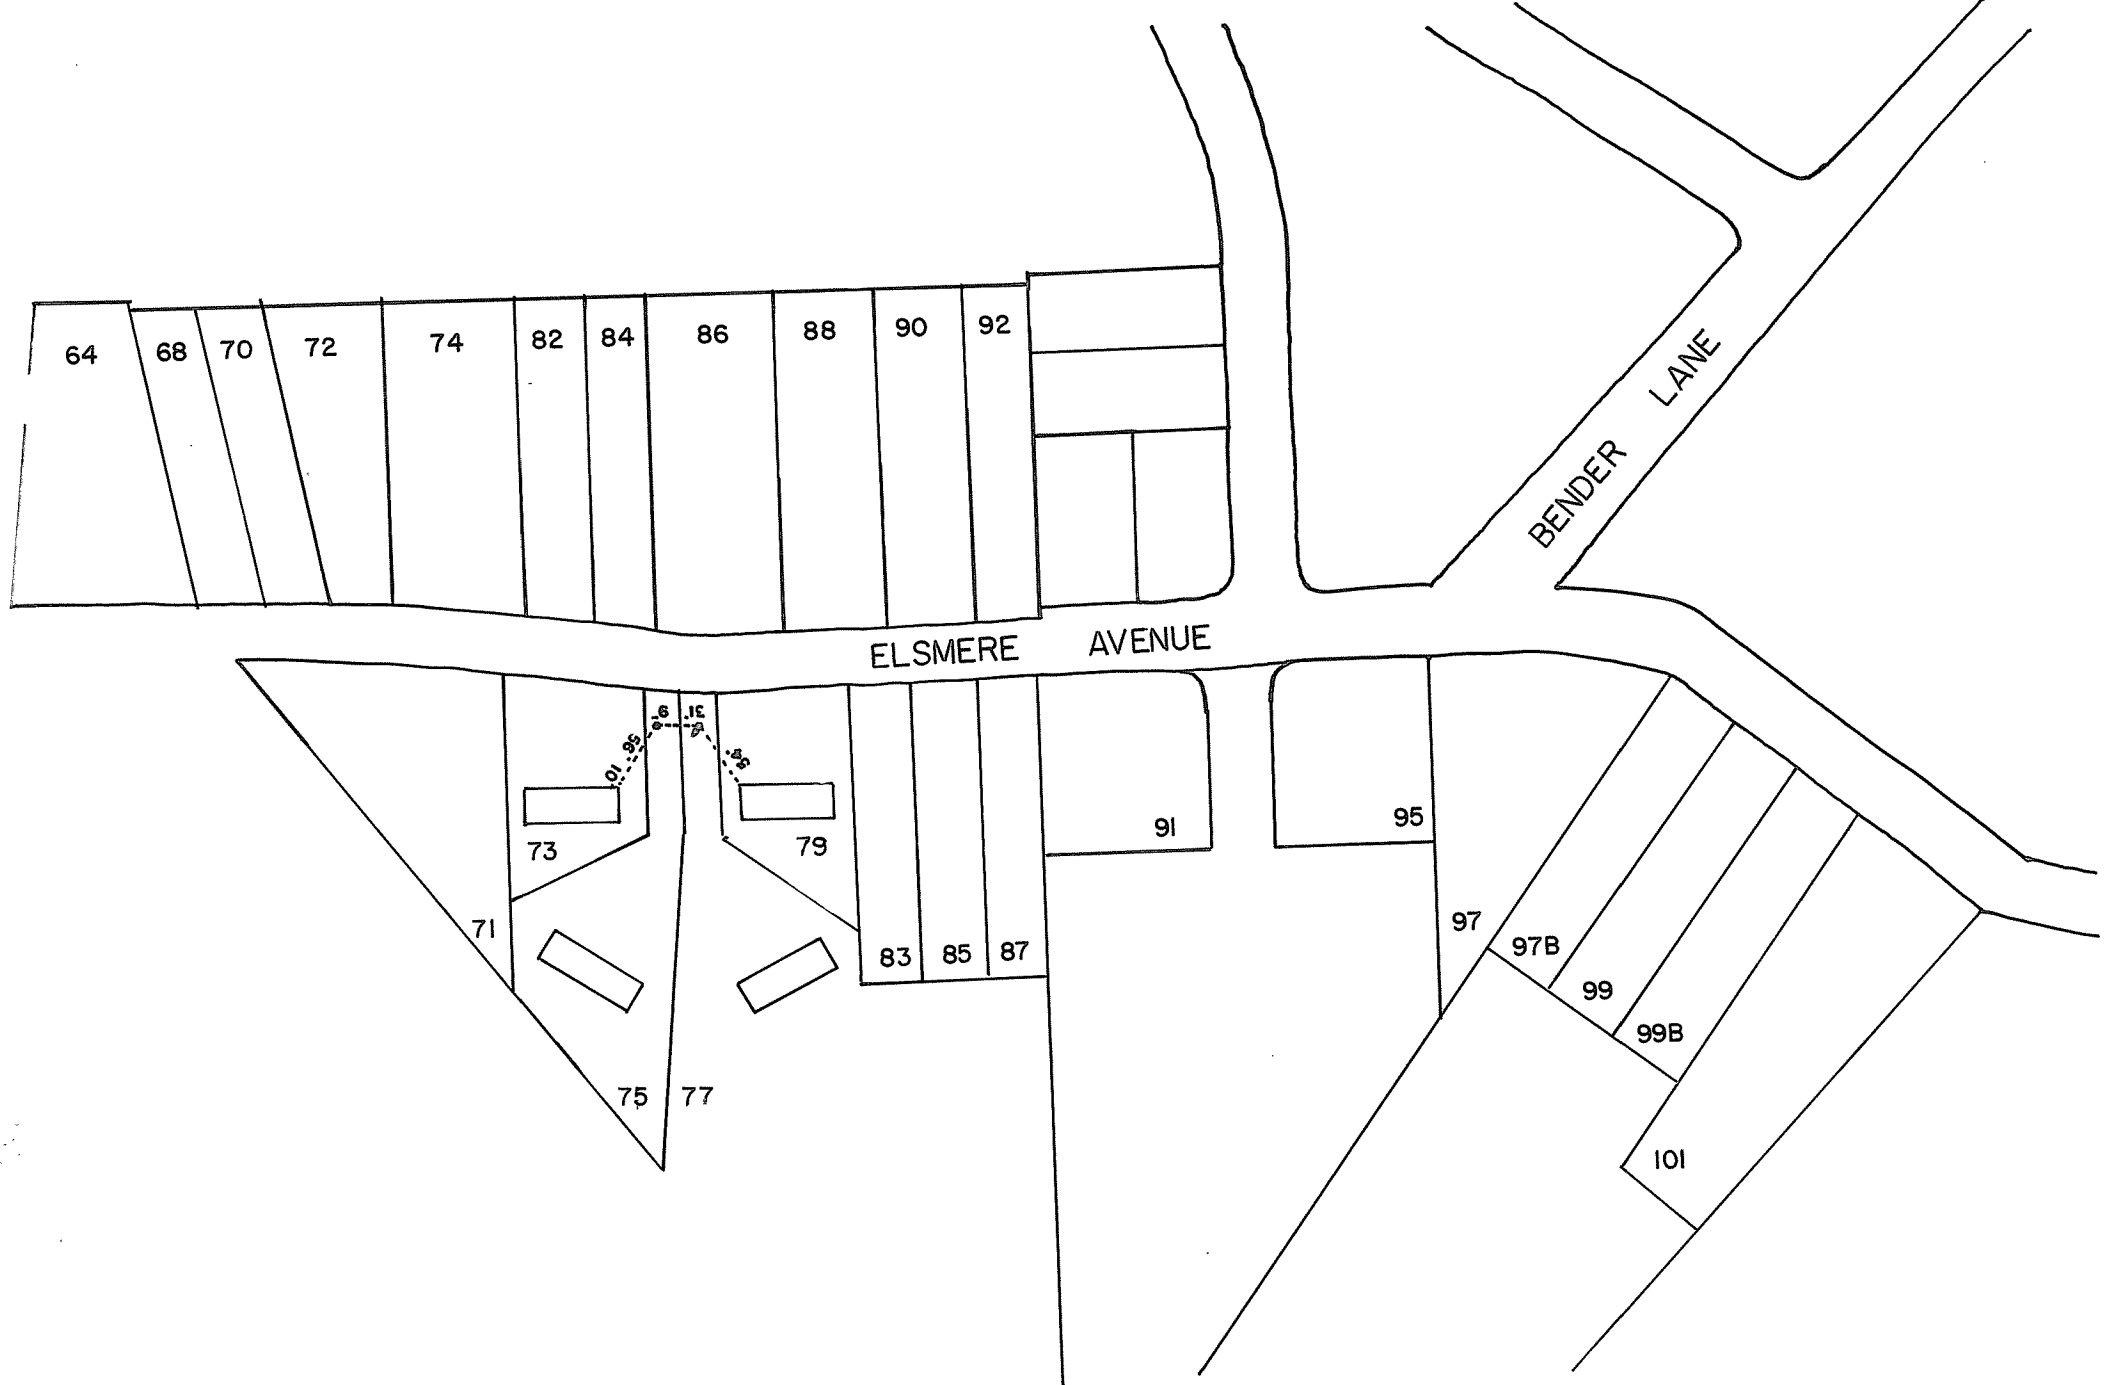

64

68

70

72

74

82

84

86

88

90

92

ELSMERE AVENUE

BENDER LANE

73

71

75

77

79

83

85

87

91

95

97

97B

99

99B

101