

ELSMERE AVENUE

WATER DISTRICT NO.1

TOWN OF BETHLEHEM


RECORD OF INSTALLATION

TOWN OF BETHLEHEM ENGINEERING

DEPARTMENT

SCALE: 1" = 50' NOVEMBER, 1982

DWN. BY: PDH

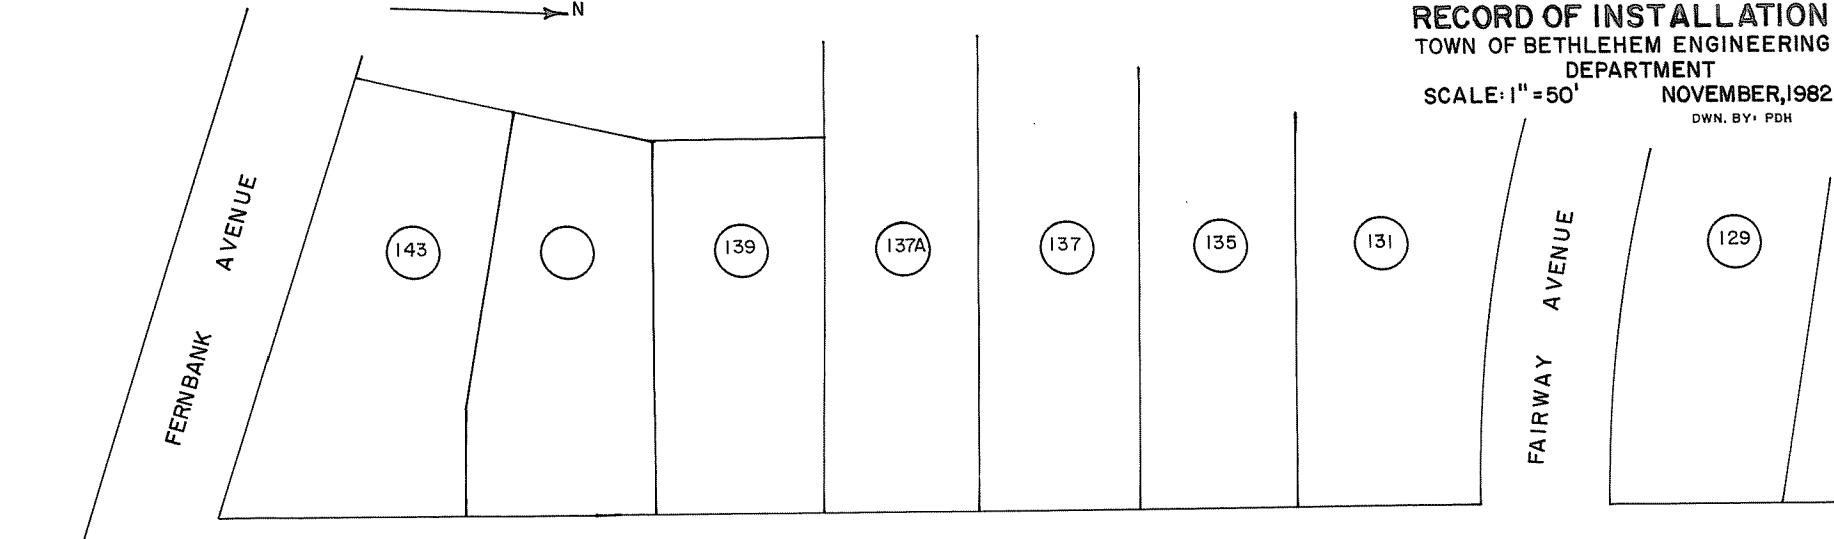

ELSMERE

AVENUE

EAST FERNBANK AVENUE

208

206

204

200

1

