


ELSMERE AVENUE  
WATER DISTRICT NO.1  
TOWN OF BETHLEHEM  
RECORD OF INSTALLATION  
TOWN OF BETHLEHEM ENGINEERING  
DEPARTMENT  
SCALE: 1"=50' NOVEMBER, 1982  
DWN. BY: PDH



ELSMERE

AVENUE

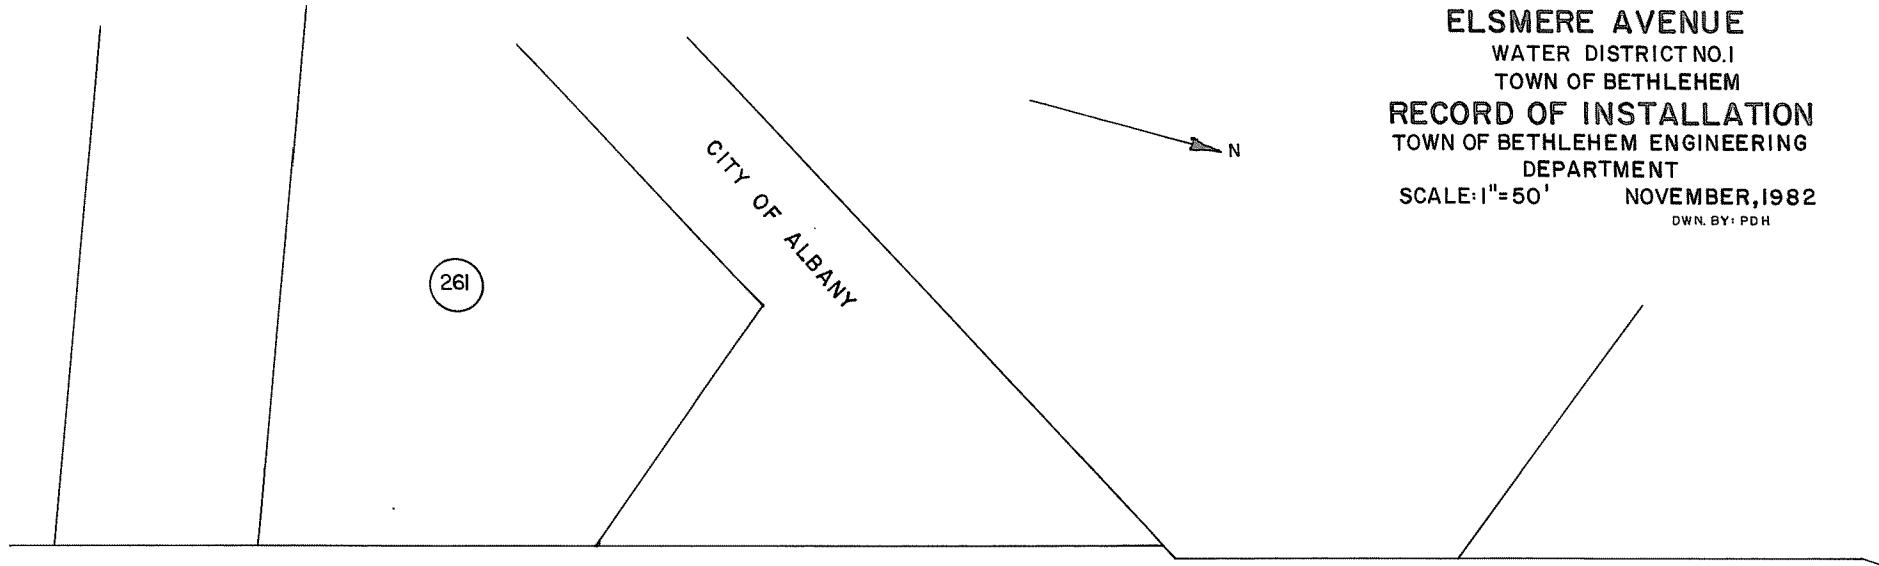